




0055_393

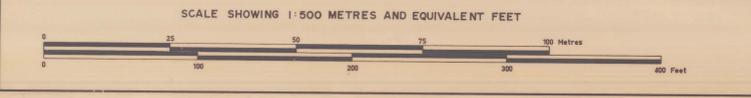

ELECTROLYTIC ZINC COMPANY OF AUSTRALASIA LIMITED
WEST COAST MINES, T.A.S.

| | | | |
|-----------|--------|-----------|-------|
| SURVEY BY | | SCALE | 1:500 |
| DRAWN BY | | DATE | 1975 |
| TRACED BY | I.T.M. | REFERENCE | |

ROSEBERY MINE
No 8 LEVEL (3)

DRAWING No: 1 2 3

REPROVED

DEPARTMENT OF MINES
BROUGHT TO DATE: 31.12.75
MINE MANAGER: *[Signature]*
MINE SURVEYOR: *[Signature]*



0055_393

750/5