


0055\_395

**MICROFILMED**

DEPARTMENT OF MINES  
 BROUGHT TO DATE: 31.12.75  
 MINE MANAGER: *[Signature]*  
 MINE SURVEYOR: *[Signature]*

0055\_395

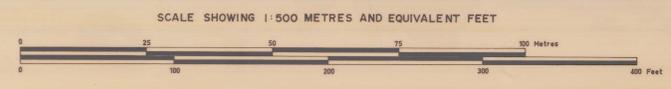

**ELECTROLYTIC ZINC COMPANY OF AUSTRALASIA LIMITED**  
 WEST COAST MINES, T.A.S.

SURVEY BY		SCALE	1:500
DRAWN BY		DATE	1975
TRACED BY	I.T.M.	REFERENCE	

ROSEBERY MINE  
 N° 8 LEVEL ①

DRAWING N°:  
 ① ② ③

7541