


0055_396

MICROFILMED

DEPARTMENT OF MINES
 BROUGHT TO DATE: 31.12.75
 MINE MANAGER: *[Signature]*
 MINE SURVEYOR: *[Signature]*

0055_396

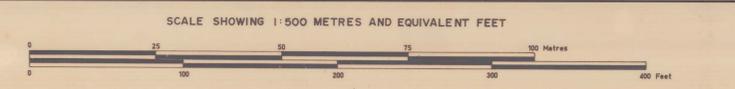

ELECTROLYTIC ZINC COMPANY OF AUSTRALASIA LIMITED
 WEST COAST MINES, T.A.S.

SURVEY BY		SCALE	1:500
DRAWN BY		DATE	1975
TRACED BY	RJR	REFERENCE	

ROSEBERY MINE
 N° 6 LEVEL (3)

DRAWING N°:
 ① ② ③

78/40