


0055_400

MINE SURVEYOR'S SIGNATURE

DEPARTMENT OF MINES
 BROUGHT TO DATE: 31.12.75
 MINE MANAGER: *R. Pipey*
 MINE SURVEYOR: *[Signature]*



0055_400

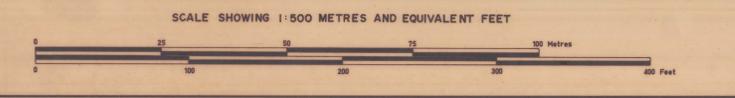

ELECTROLYTIC ZINC COMPANY OF AUSTRALASIA LIMITED
 WEST COAST MINES, T.A.S.

SURVEY BY		SCALE	1:500
DRAWN BY		DATE	1975
TRACED BY	RJR	REFERENCE	

ROSEBERY MINE
 No 4 LEVEL (1)

DRAWING No:
 (1) (2) (3)

75056