


0055_401

DEPARTMENT OF MINES
 BROUGHT TO DATE: 31-12-75
 MINE MANAGER: *[Signature]*
 MINE SURVEYOR: *[Signature]*

5m
 0055-401

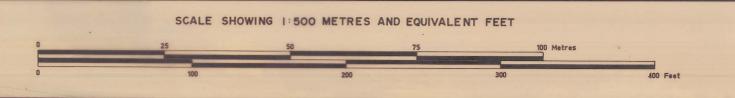

ELECTROLYTIC ZINC COMPANY OF AUSTRALASIA LIMITED
 WEST COAST MINES, T.A.S.

SURVEY BY		SCALE	1:500
DRAWN BY		DATE	1975
TRACED BY	RJR	REFERENCE	

ROSEBERY MINE
 No 10 LEVEL ①

DRAWING No: ① ② ③
 7847