




0055_403

MISPLACED
MISPLACED

DEPARTMENT OF MINES
BROUGHT TO DATE: 31/12/75
MINE MANAGER: *[Signature]*
MINE SURVEYOR: *[Signature]*

0055_403

5.0m

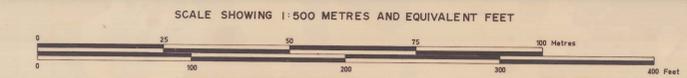

ELECTROLYTIC ZINC COMPANY OF AUSTRALASIA LIMITED
WEST COAST MINES, T.A.S.

SURVEY BY		SCALE	1:500
DRAWN BY		DATE	1975
TRACED BY	I.T.M.	REFERENCE	

ROSEBERY MINE
Nº 14 LEVEL (3)

DRAWING N^o :

5	6
3	4
1	2

75060