



0055_404

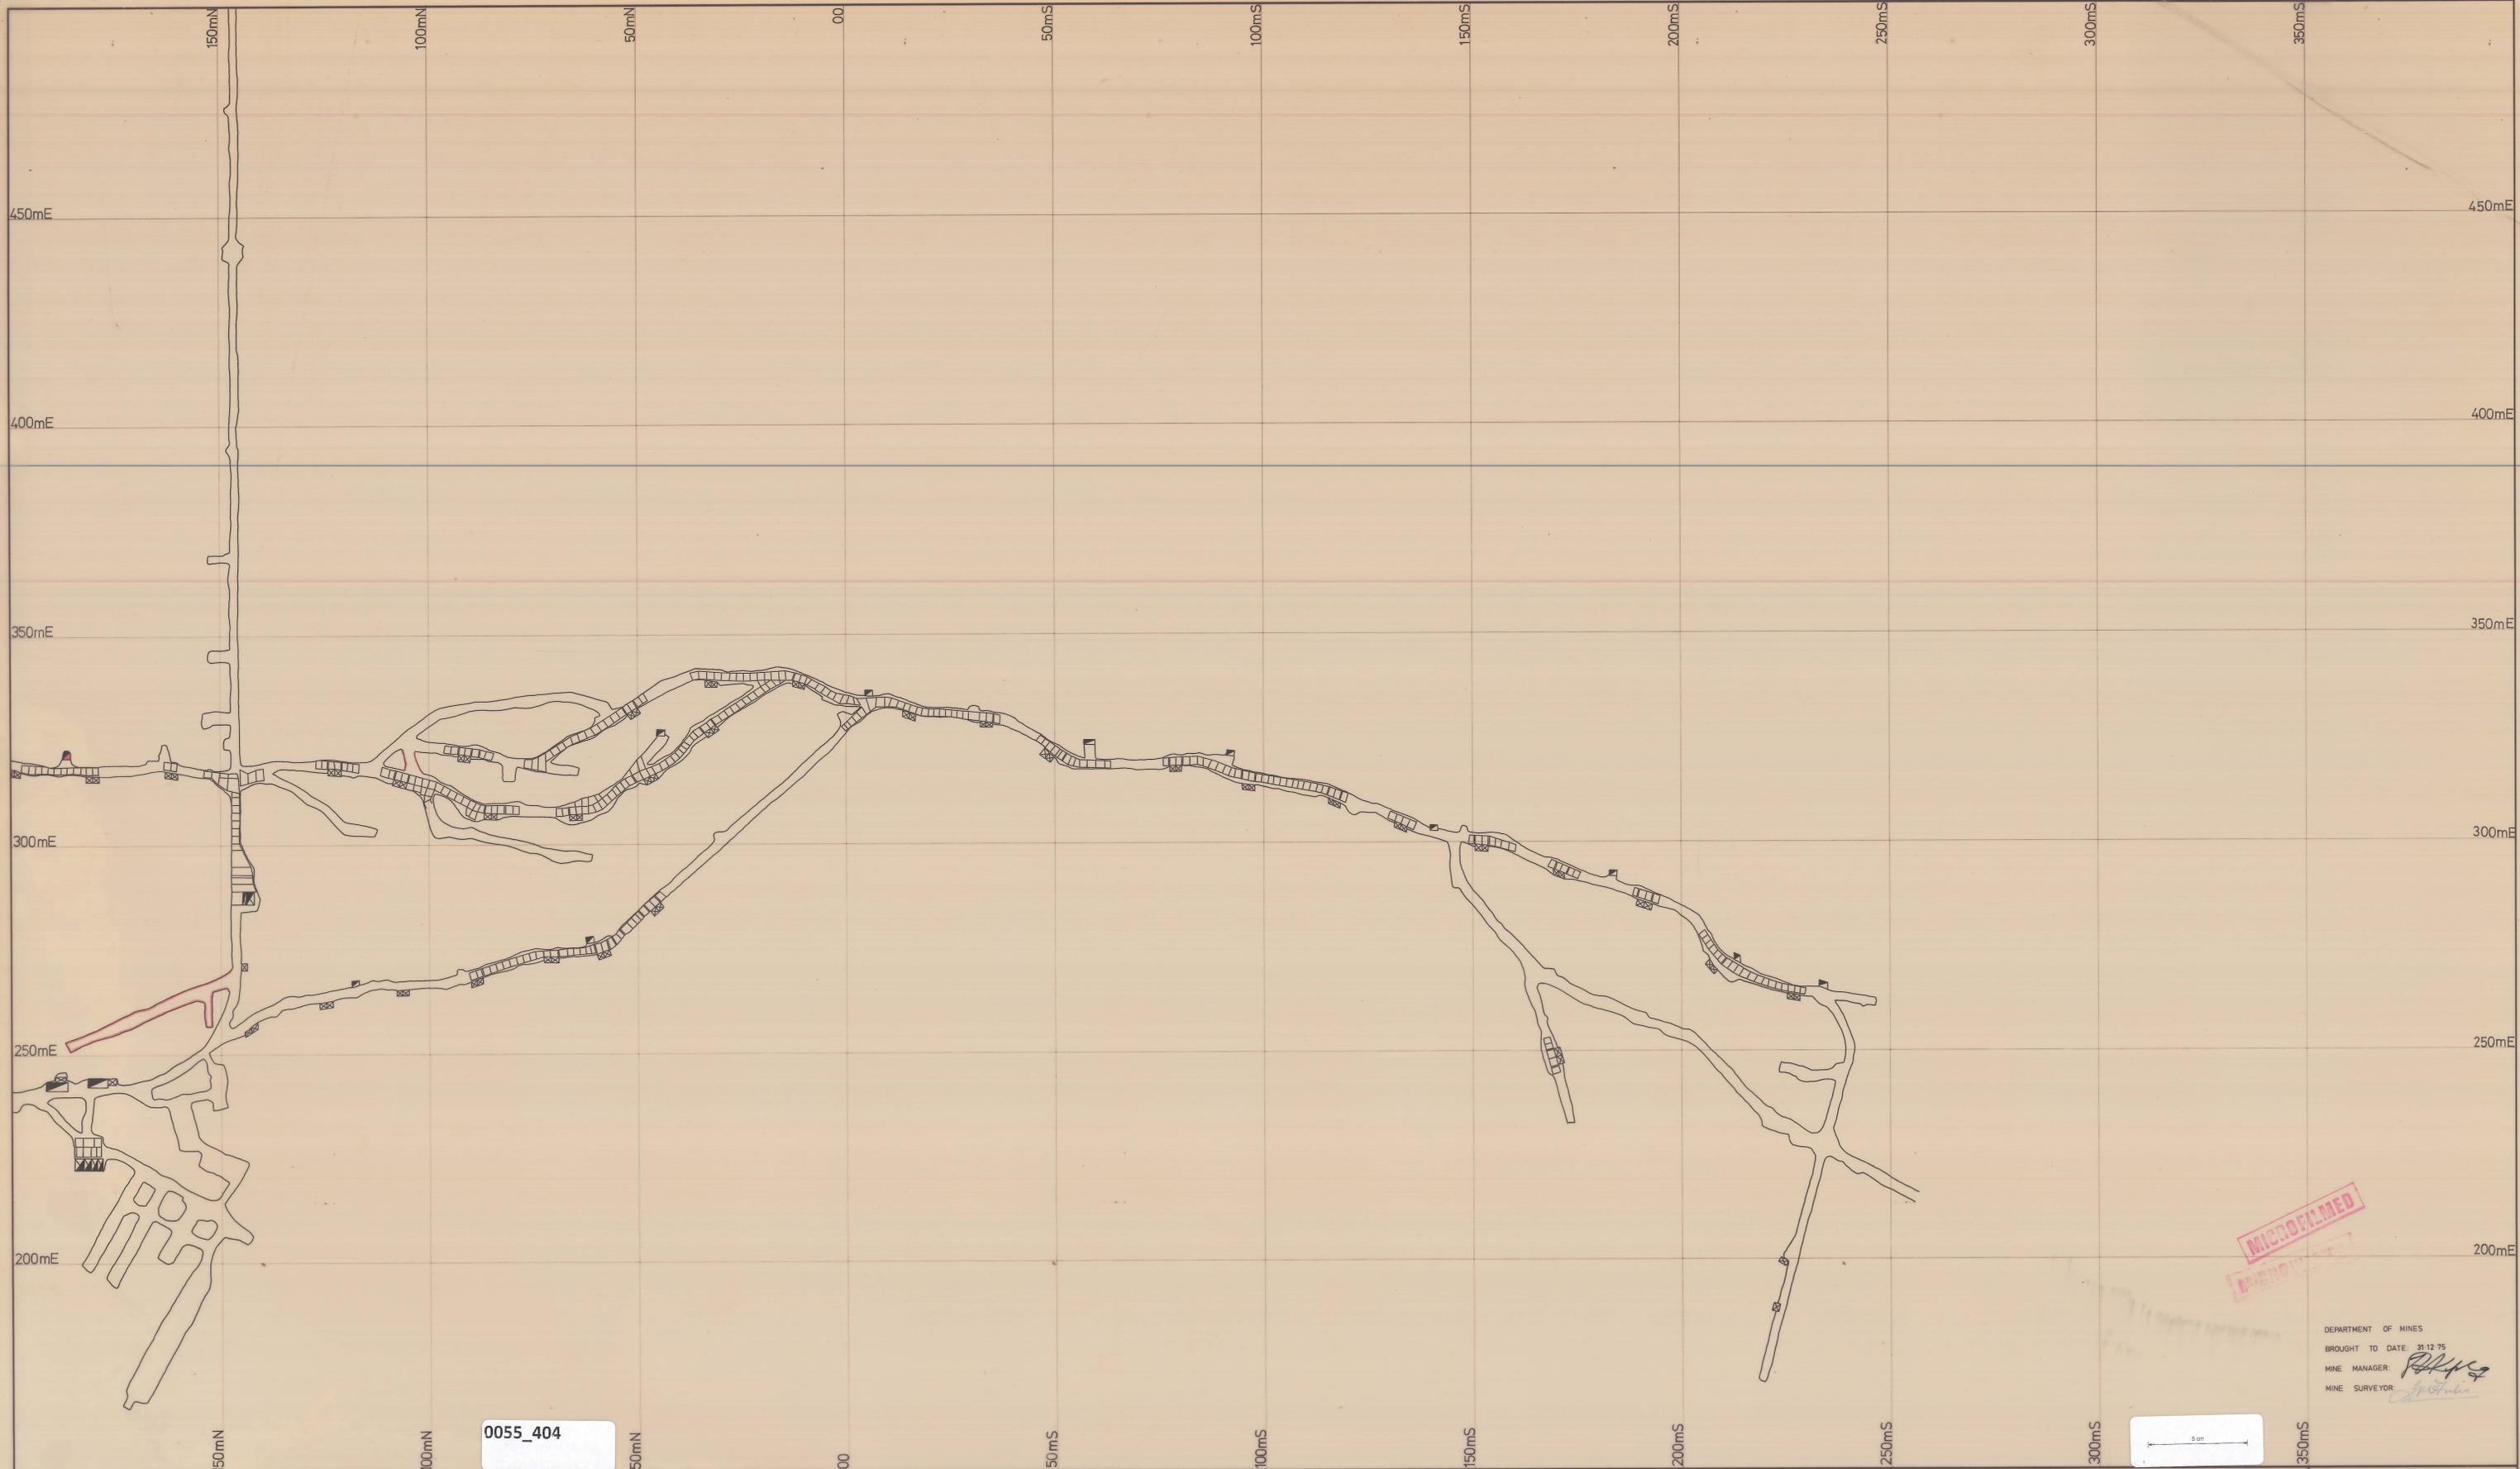

0055_404

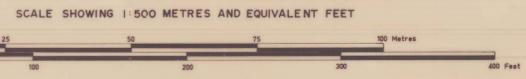

ELECTROLYTIC ZINC COMPANY OF AUSTRALASIA LIMITED
WEST COAST MINES, T.A.S.

SURVEY BY	SCALE	1 : 500
DRAWN BY	DATE	1975
TRACED BY I.T.M.	REFERENCE	

ROSEBERY MINE
No 14 LEVEL (2)

DEPARTMENT OF MINES
BROUGHT TO DATE: 31.12.75
MINE MANAGER: *[Signature]*
MINE SURVEYOR: *[Signature]*

DRAWING N°:

⑤	⑥
③	④
①	②

7639