


0055\_405

MICROFILMED  
MICROFILMED

DEPARTMENT OF MINES  
BROUGHT TO DATE 31-12-75  
MINE MANAGER *[Signature]*  
MINE SURVEYOR *[Signature]*

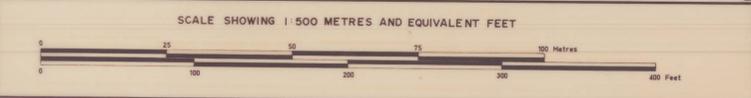

ELECTROLYTIC ZINC COMPANY OF AUSTRALASIA LIMITED  
WEST COAST MINES, T.A.S.

SURVEY BY		SCALE	1:500
DRAWN BY		DATE	1975
TRACED BY	I.T.M.	REFERENCE	

0055\_405

ROSEBERY MINE  
Nº 14 LEVEL ①

DRAWING N°:

⑤	⑥
③	④
①	②

8002