
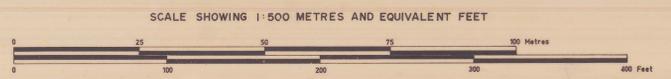


0055_406

MICROFILMED
MICROFILMED

DEPARTMENT OF MINES
BROUGHT TO DATE: 31.12.75
MINE MANAGER: *[Signature]*
MINE SURVEYOR: *[Signature]*

0055_406

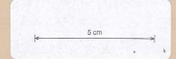

ELECTROLYTIC ZINC COMPANY OF AUSTRALASIA LIMITED
WEST COAST MINES, T.A.S.

SURVEY BY		SCALE	1:500
DRAWN BY		DATE	1975
TRACED BY	RJR	REFERENCE	

ROSEBERY MINE
Nº 13 LEVEL (2)

DRAWING N°:

① ②

78037