


0055_408

RECEIVED
MICROFILMED

DEPARTMENT OF MINES
BROUGHT TO DATE: 31-12-75
MINE MANAGER: *[Signature]*
MINE SURVEYOR: *[Signature]*

0055_408

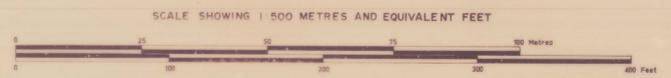

ELECTROLYTIC ZINC COMPANY OF AUSTRALASIA LIMITED
WEST COAST MINES, T.A.S.

SURVEY BY		SCALE	1: 500
DRAWN BY		DATE	1975
TRACED BY	RJR	REFERENCE	

ROSEBERY MINE
No 12 LEVEL (3)

DRAWING No: 1 2 3

76055