


0055_413

MICROFILMED

MICROFILMED

DEPARTMENT OF MINES
 BROUGHT TO DATE: 31.12.75
 MINE MANAGER: *[Signature]*
 MINE SURVEYOR: *[Signature]*

0055_413

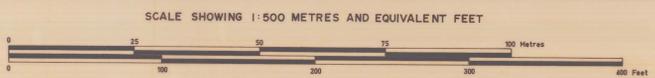

ELECTROLYTIC ZINC COMPANY OF AUSTRALASIA LIMITED
 WEST COAST MINES, T.A.S.

| | | | |
|-----------|--------|-----------|-------|
| SURVEY BY | | SCALE | 1:500 |
| DRAWN BY | | DATE | 1975 |
| TRACED BY | I.T.M. | REFERENCE | |

ROSEBERY MINE
 N^o 11 LEVEL ①

DRAWING N^o:



720.00