

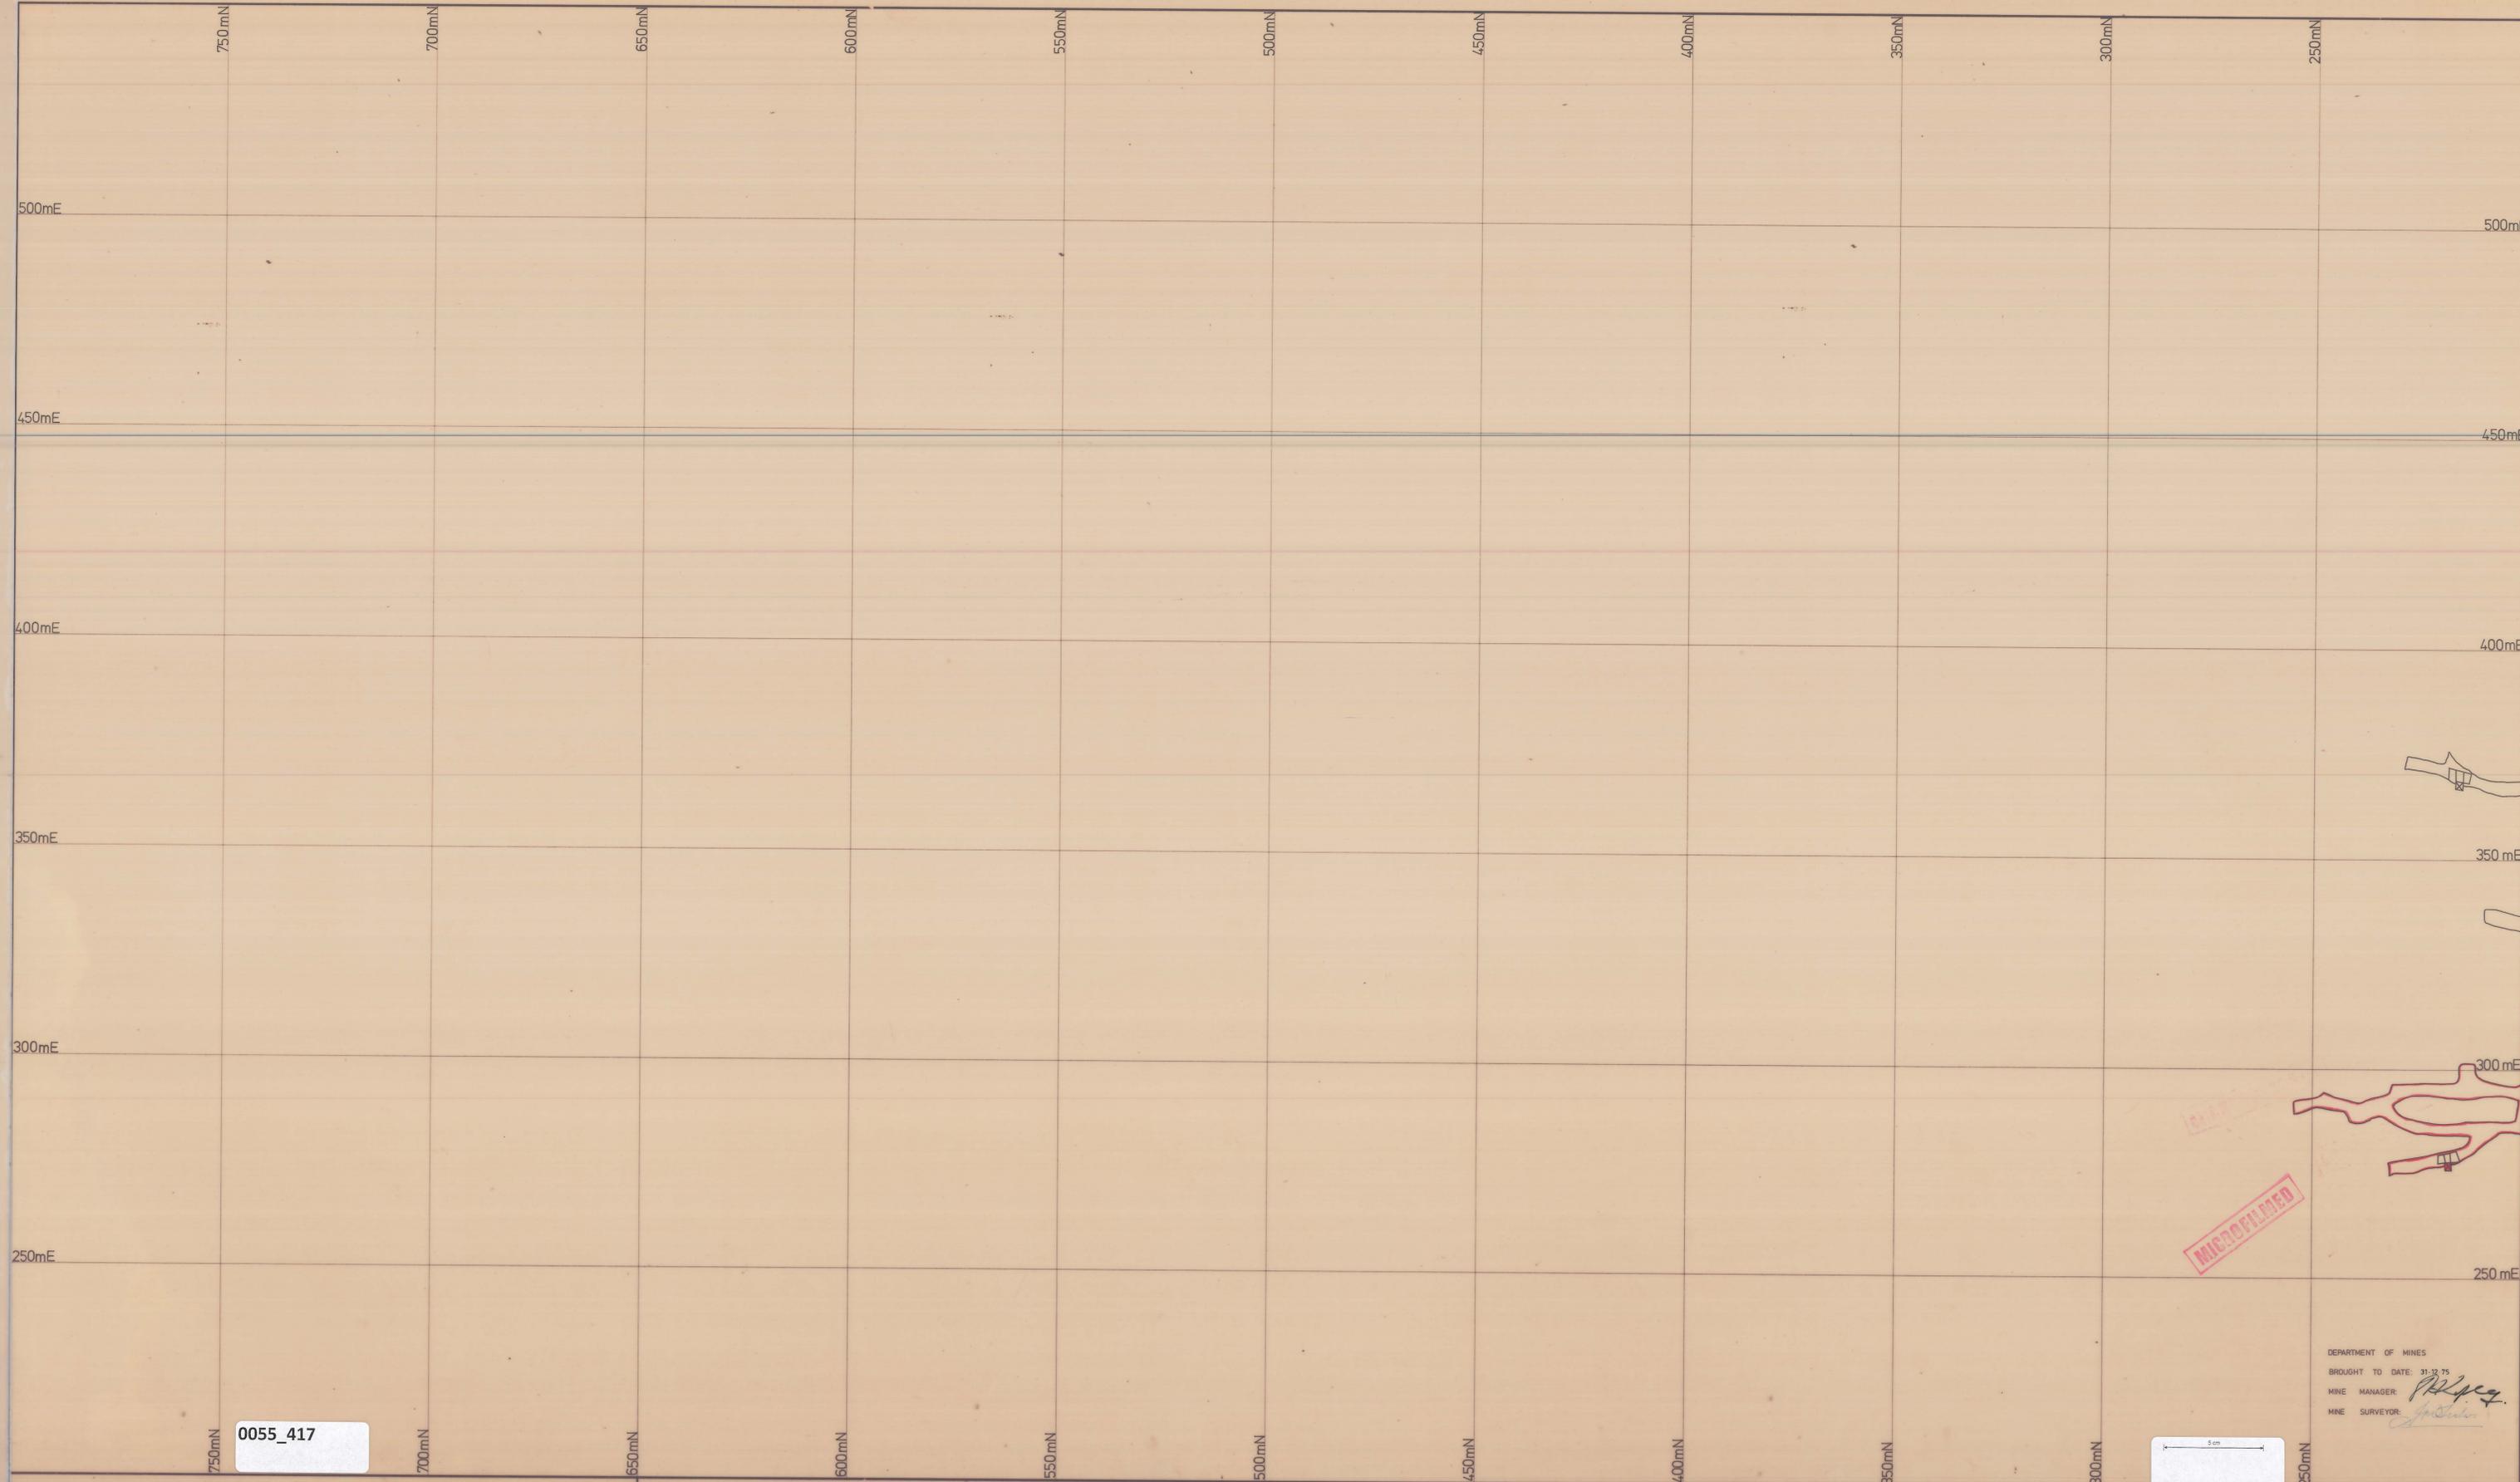


0055_417

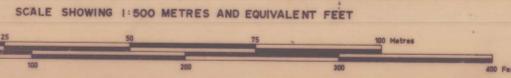

0055_417

MICROFILMED

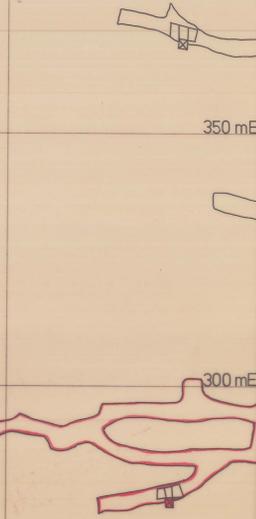

ELECTROLYTIC ZINC COMPANY OF AUSTRALASIA LIMITED
 WEST COAST MINES, T.A.S.

SURVEY BY	SCALE	1:500
DRAWN BY	DATE	1975
TRACED BY I.T.M.	REFERENCE	

ROSEBERRY MINE
 N° 16 LEVEL ①

DEPARTMENT OF MINES
 BROUGHT TO DATE: 31-12-75
 MINE MANAGER: *[Signature]*
 MINE SURVEYOR: *[Signature]*

DRAWING N°:
 ① ② ③

7867