



0055\_418

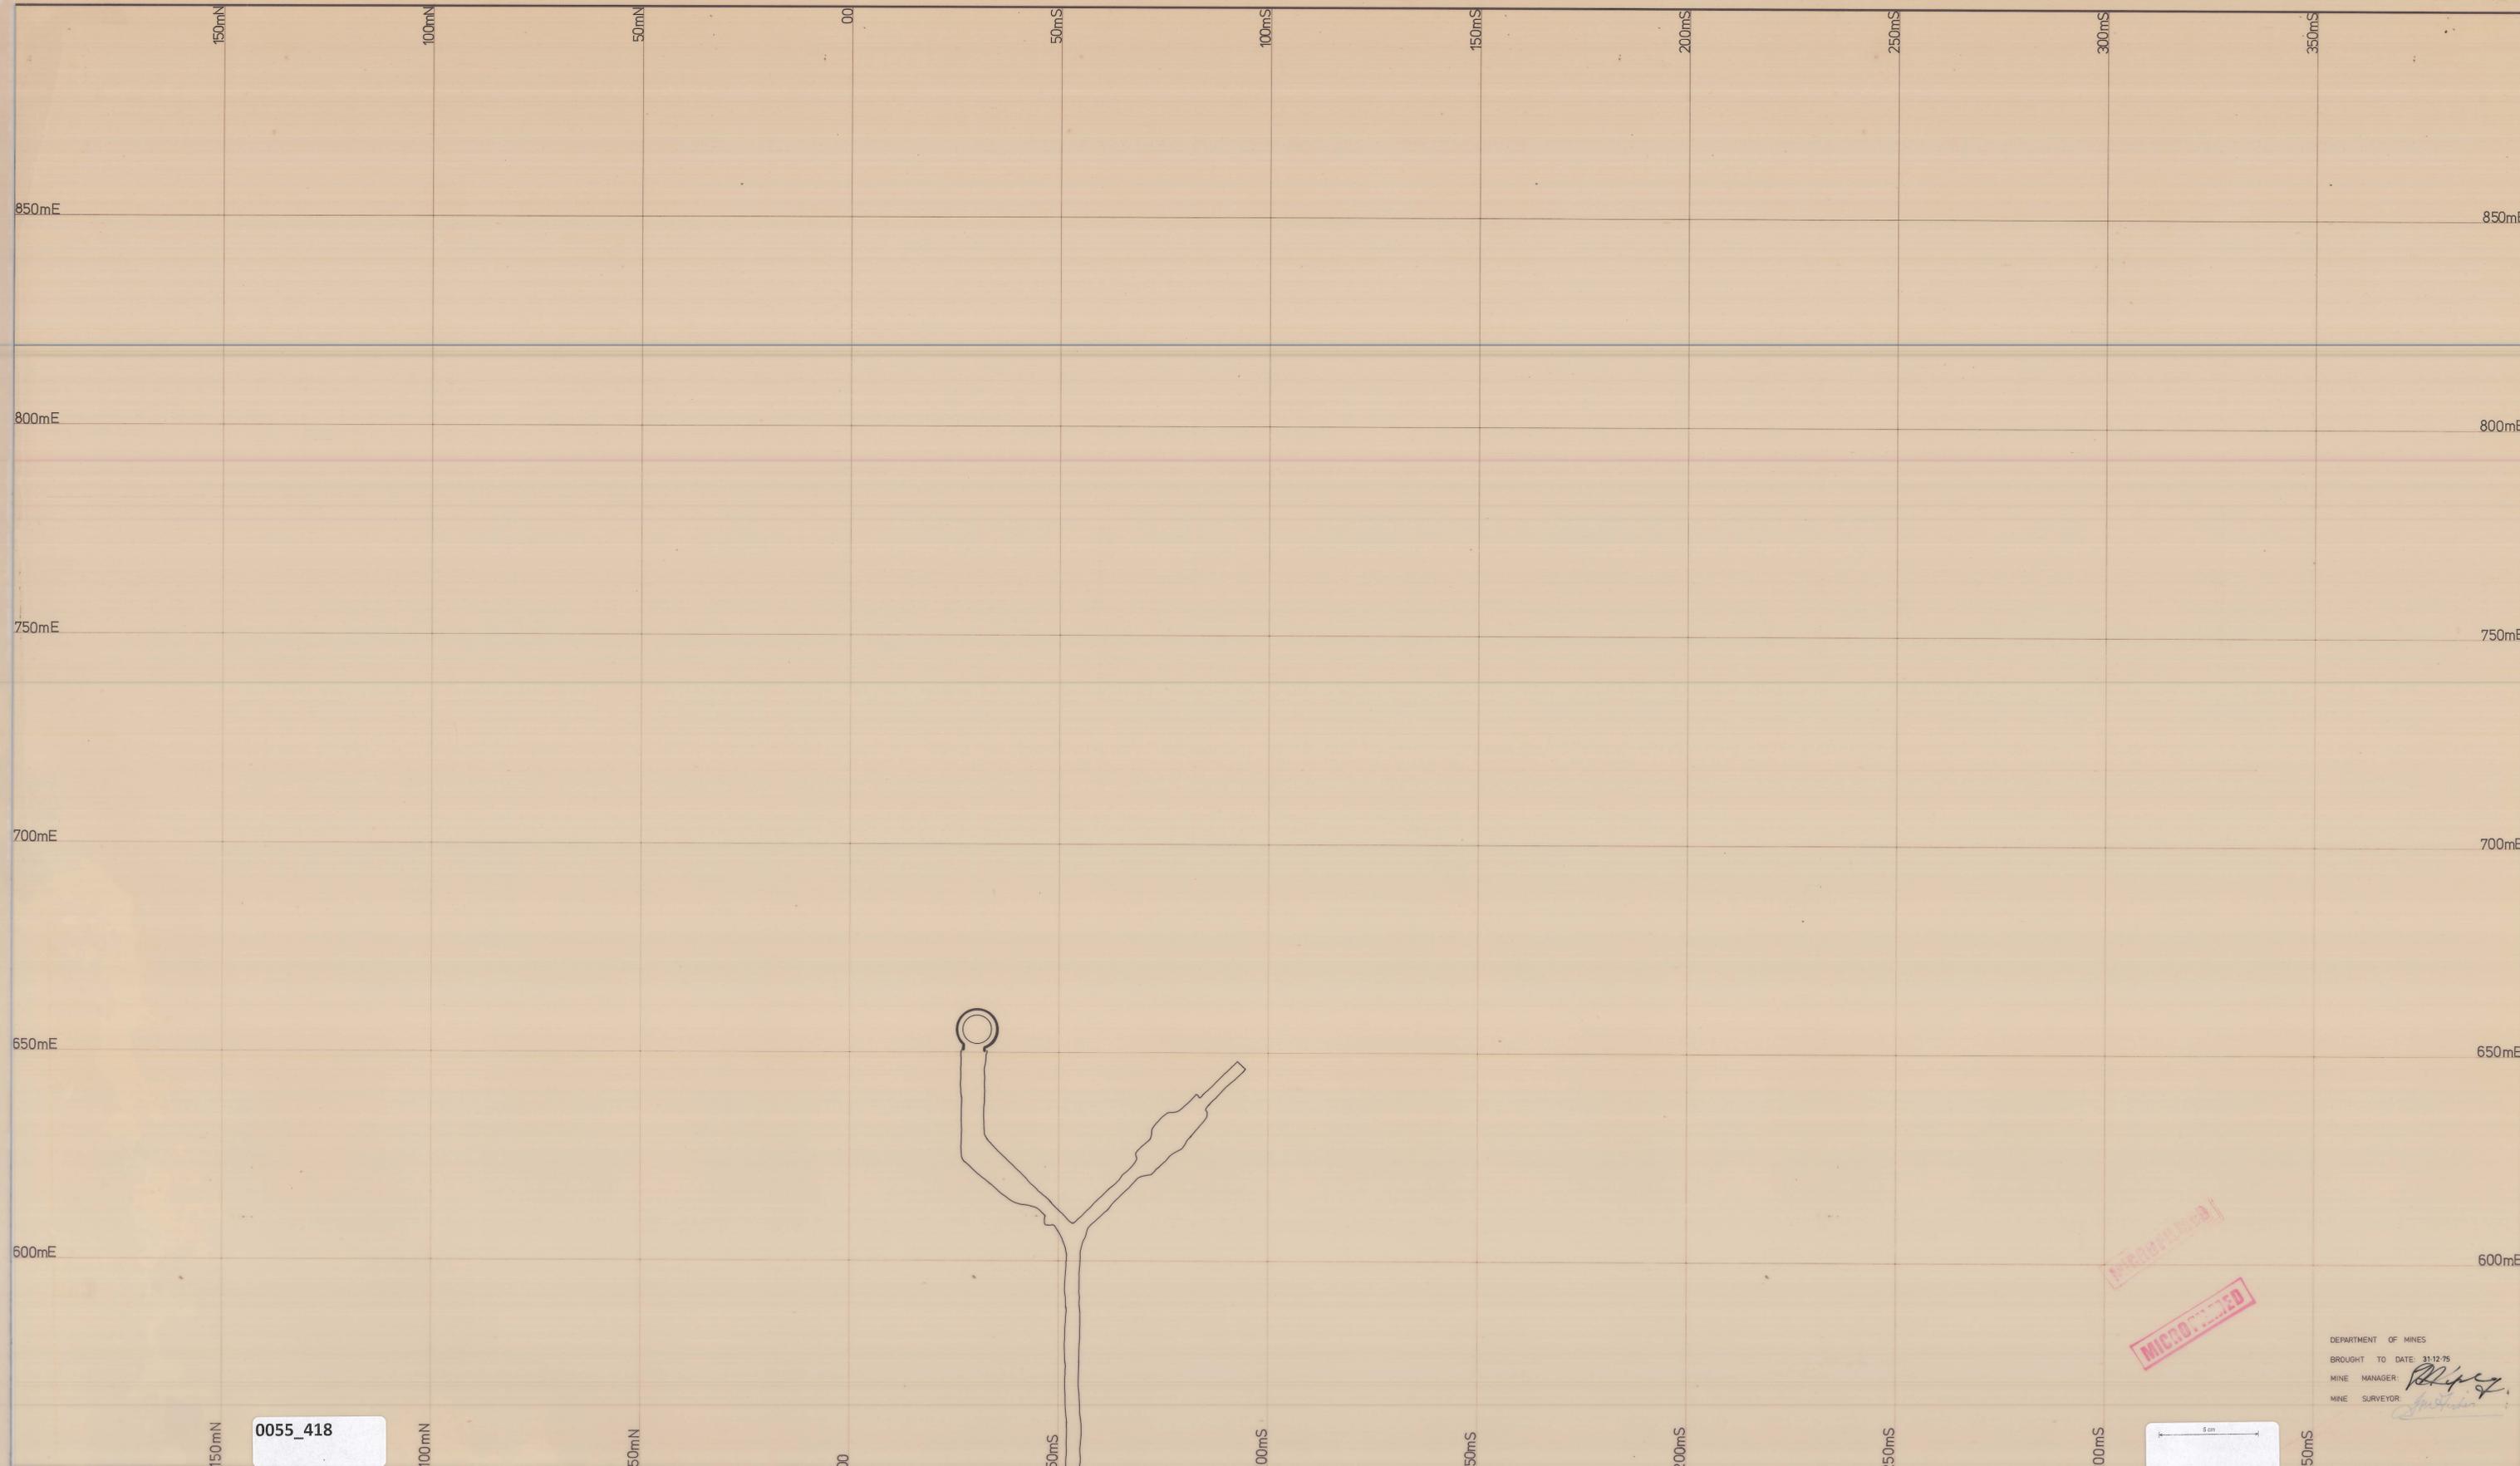

PROBATION  
MICROFILMED

DEPARTMENT OF MINES  
BROUGHT TO DATE 31-12-75  
MINE MANAGER *[Signature]*  
MINE SURVEYOR *[Signature]*

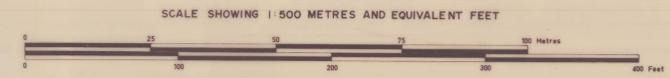

0055\_418

ELECTROLYTIC ZINC COMPANY OF AUSTRALASIA LIMITED  
WEST COAST MINES, T.A.S.

|           |     |           |       |
|-----------|-----|-----------|-------|
| SURVEY BY |     | SCALE     | 1:500 |
| DRAWN BY  |     | DATE      | 1975  |
| TRACED BY | RJR | REFERENCE |       |

ROSEBERY MINE  
Nº 15 LEVEL (3)

DRAWING Nº:  
① ② ③  
7606