


0055_419



0055_419

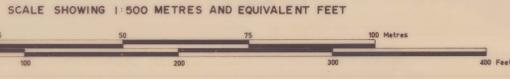

ELECTROLYTIC ZINC COMPANY OF AUSTRALASIA LIMITED
WEST COAST MINES, T.A.S.

SURVEY BY	SCALE	1:500
DRAWN BY	DATE	1975
TRACED BY R.J.R.	REFERENCE	

ROSEBERY MINE
No 15 LEVEL (2)

DEPARTMENT OF MINES
BROUGHT TO DATE: 31-12-75
MINE MANAGER: *[Signature]*
MINE SURVEYOR: *[Signature]*

DRAWING NO:

1	2	3
---	---	---

MICROFILMED
MINE FILES



76065