


0055\_421



0055\_421

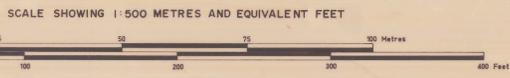

ELECTROLYTIC ZINC COMPANY OF AUSTRALASIA LIMITED  
WEST COAST MINES, T.A.S.

SURVEY BY		SCALE	1:500
DRAWN BY		DATE	1975
TRACED BY	J.T.M.	REFERENCE	

ROSEBERY MINE  
No 14 LEVEL (6)



DEPARTMENT OF MINES  
BROUGHT TO DATE: 31.12.75  
MINE MANAGER: *[Signature]*  
MINE SURVEYOR: *[Signature]*

DRAWING NO.:

5	6
3	4
1	2

16043