


0055_422




0055_422

SCALE SHOWING 1:500 METRES AND EQUIVALENT FEET

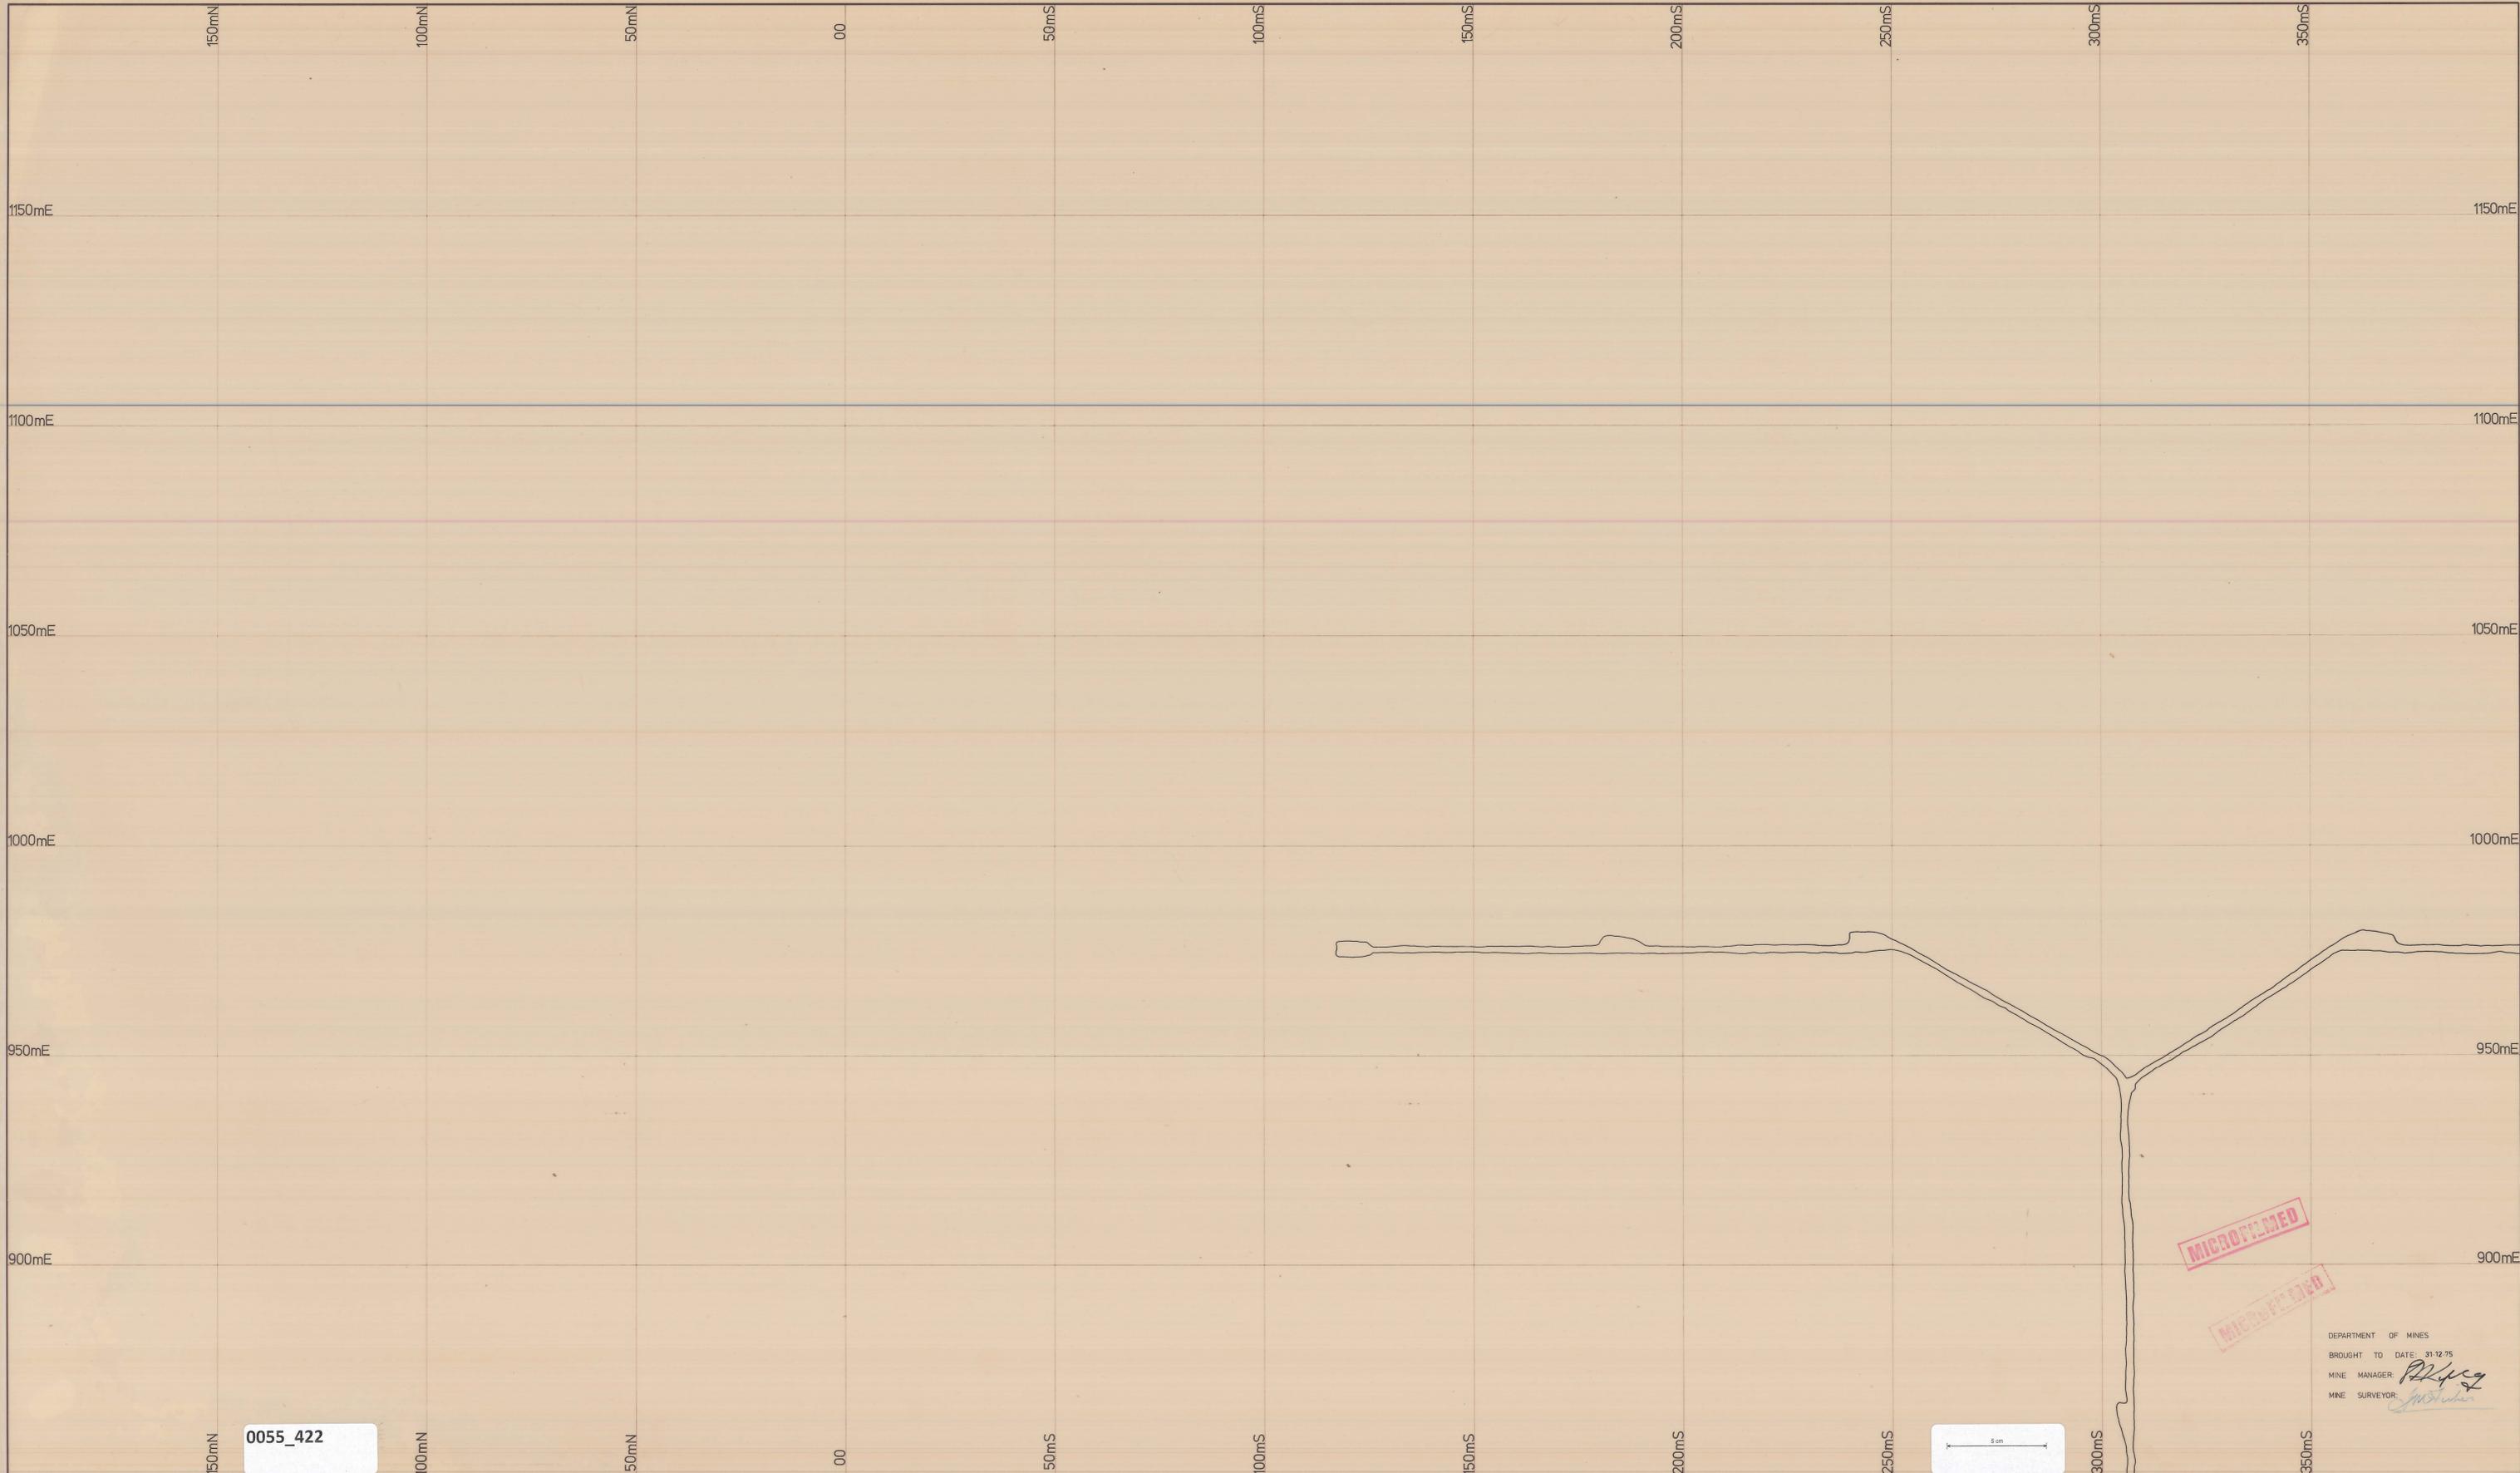

ELECTROLYTIC ZINC COMPANY OF AUSTRALASIA LIMITED
 WEST COAST MINES, TAS.

SURVEY BY	SCALE	1:500
DRAWN BY	DATE	1975
TRACED BY I.T.M.	REFERENCE	

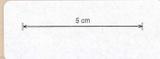

ROSEBERY MINE
 No 14 LEVEL (5)

MICROFILMED
 MICROFILMED

DEPARTMENT OF MINES
 BROUGHT TO DATE: 31-12-75
 MINE MANAGER *[Signature]*
 MINE SURVEYOR *[Signature]*

DRAWING No:

③	④
①	②

78062