



0055-423

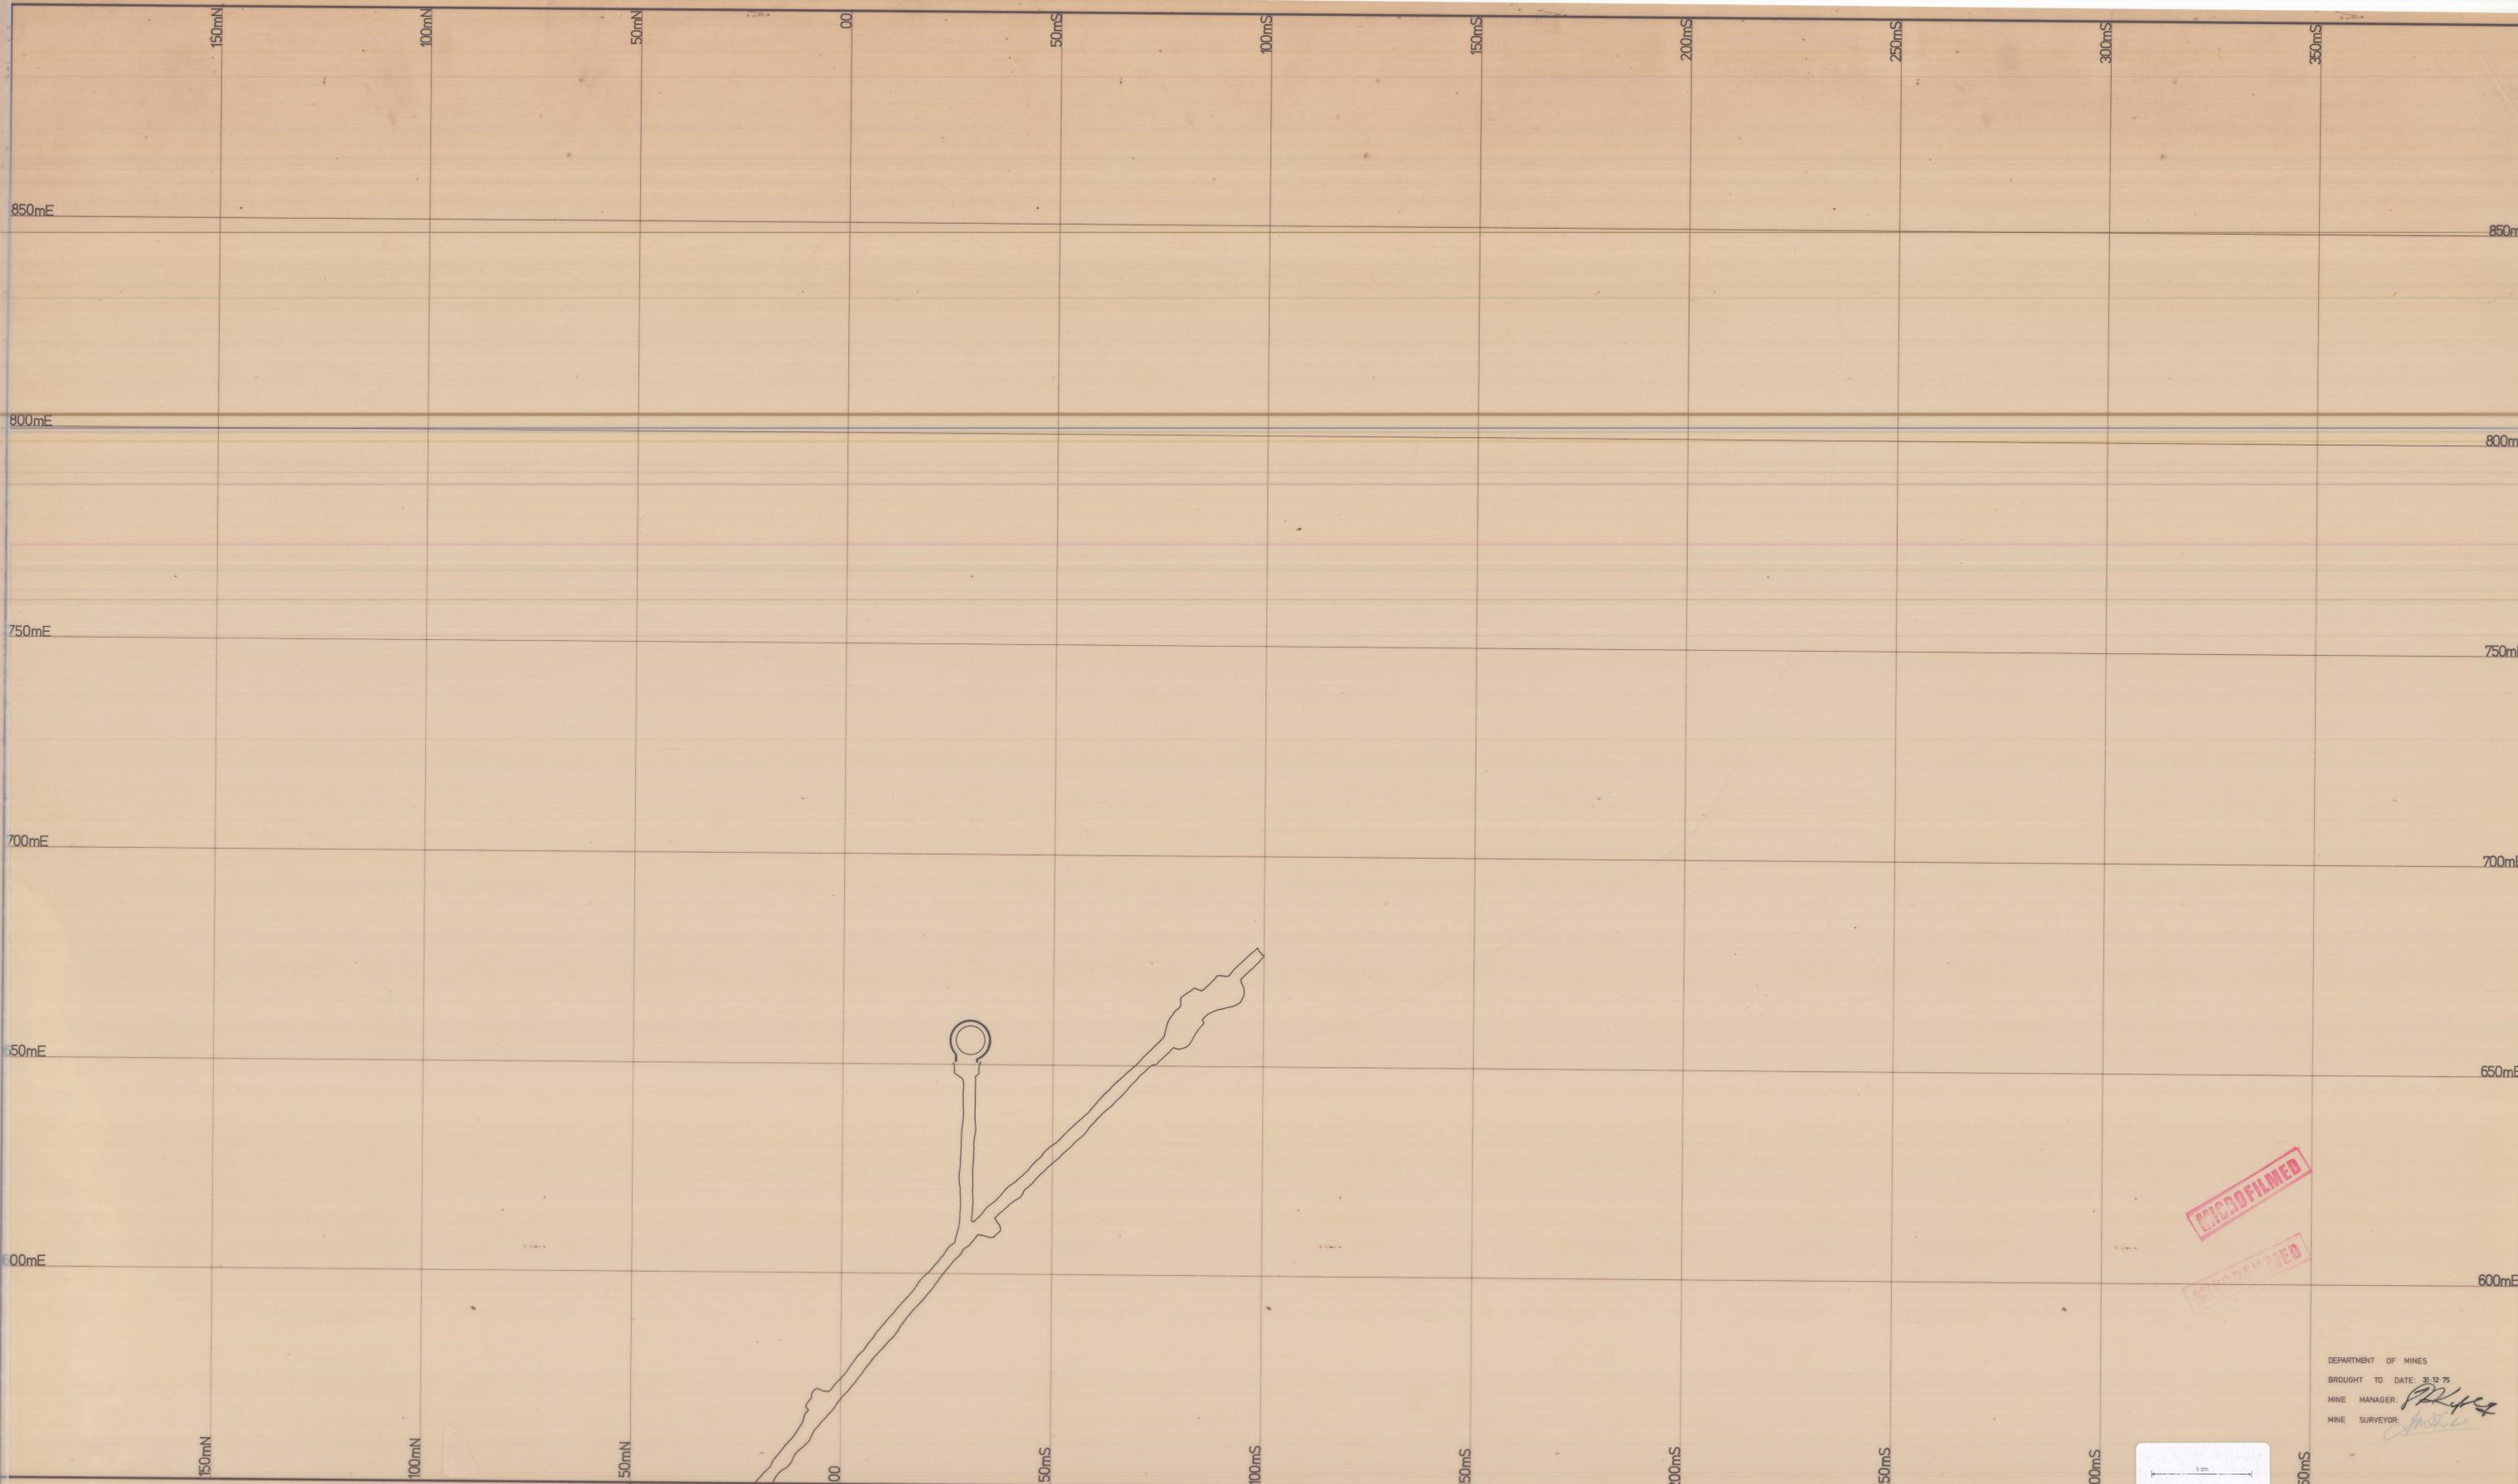

MICROFILMED

MICROFILMED

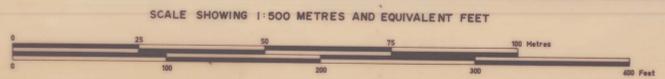

ELECTROLYTIC ZINC COMPANY OF AUSTRALASIA LIMITED  
WEST COAST MINES, TAS.

SURVEY BY		SCALE	1:500
DRAWN BY		DATE	1975
TRACED BY	I.T.M.	REFERENCE	

ROSEBERY MINE  
N<sup>o</sup> 16 LEVEL (3)

DEPARTMENT OF MINES  
BROUGHT TO DATE: 31.12.75  
MINE MANAGER: *[Signature]*  
MINE SURVEYOR: *[Signature]*

DRAWING N<sup>o</sup>:  
① ② ③  
76049