



0035-424

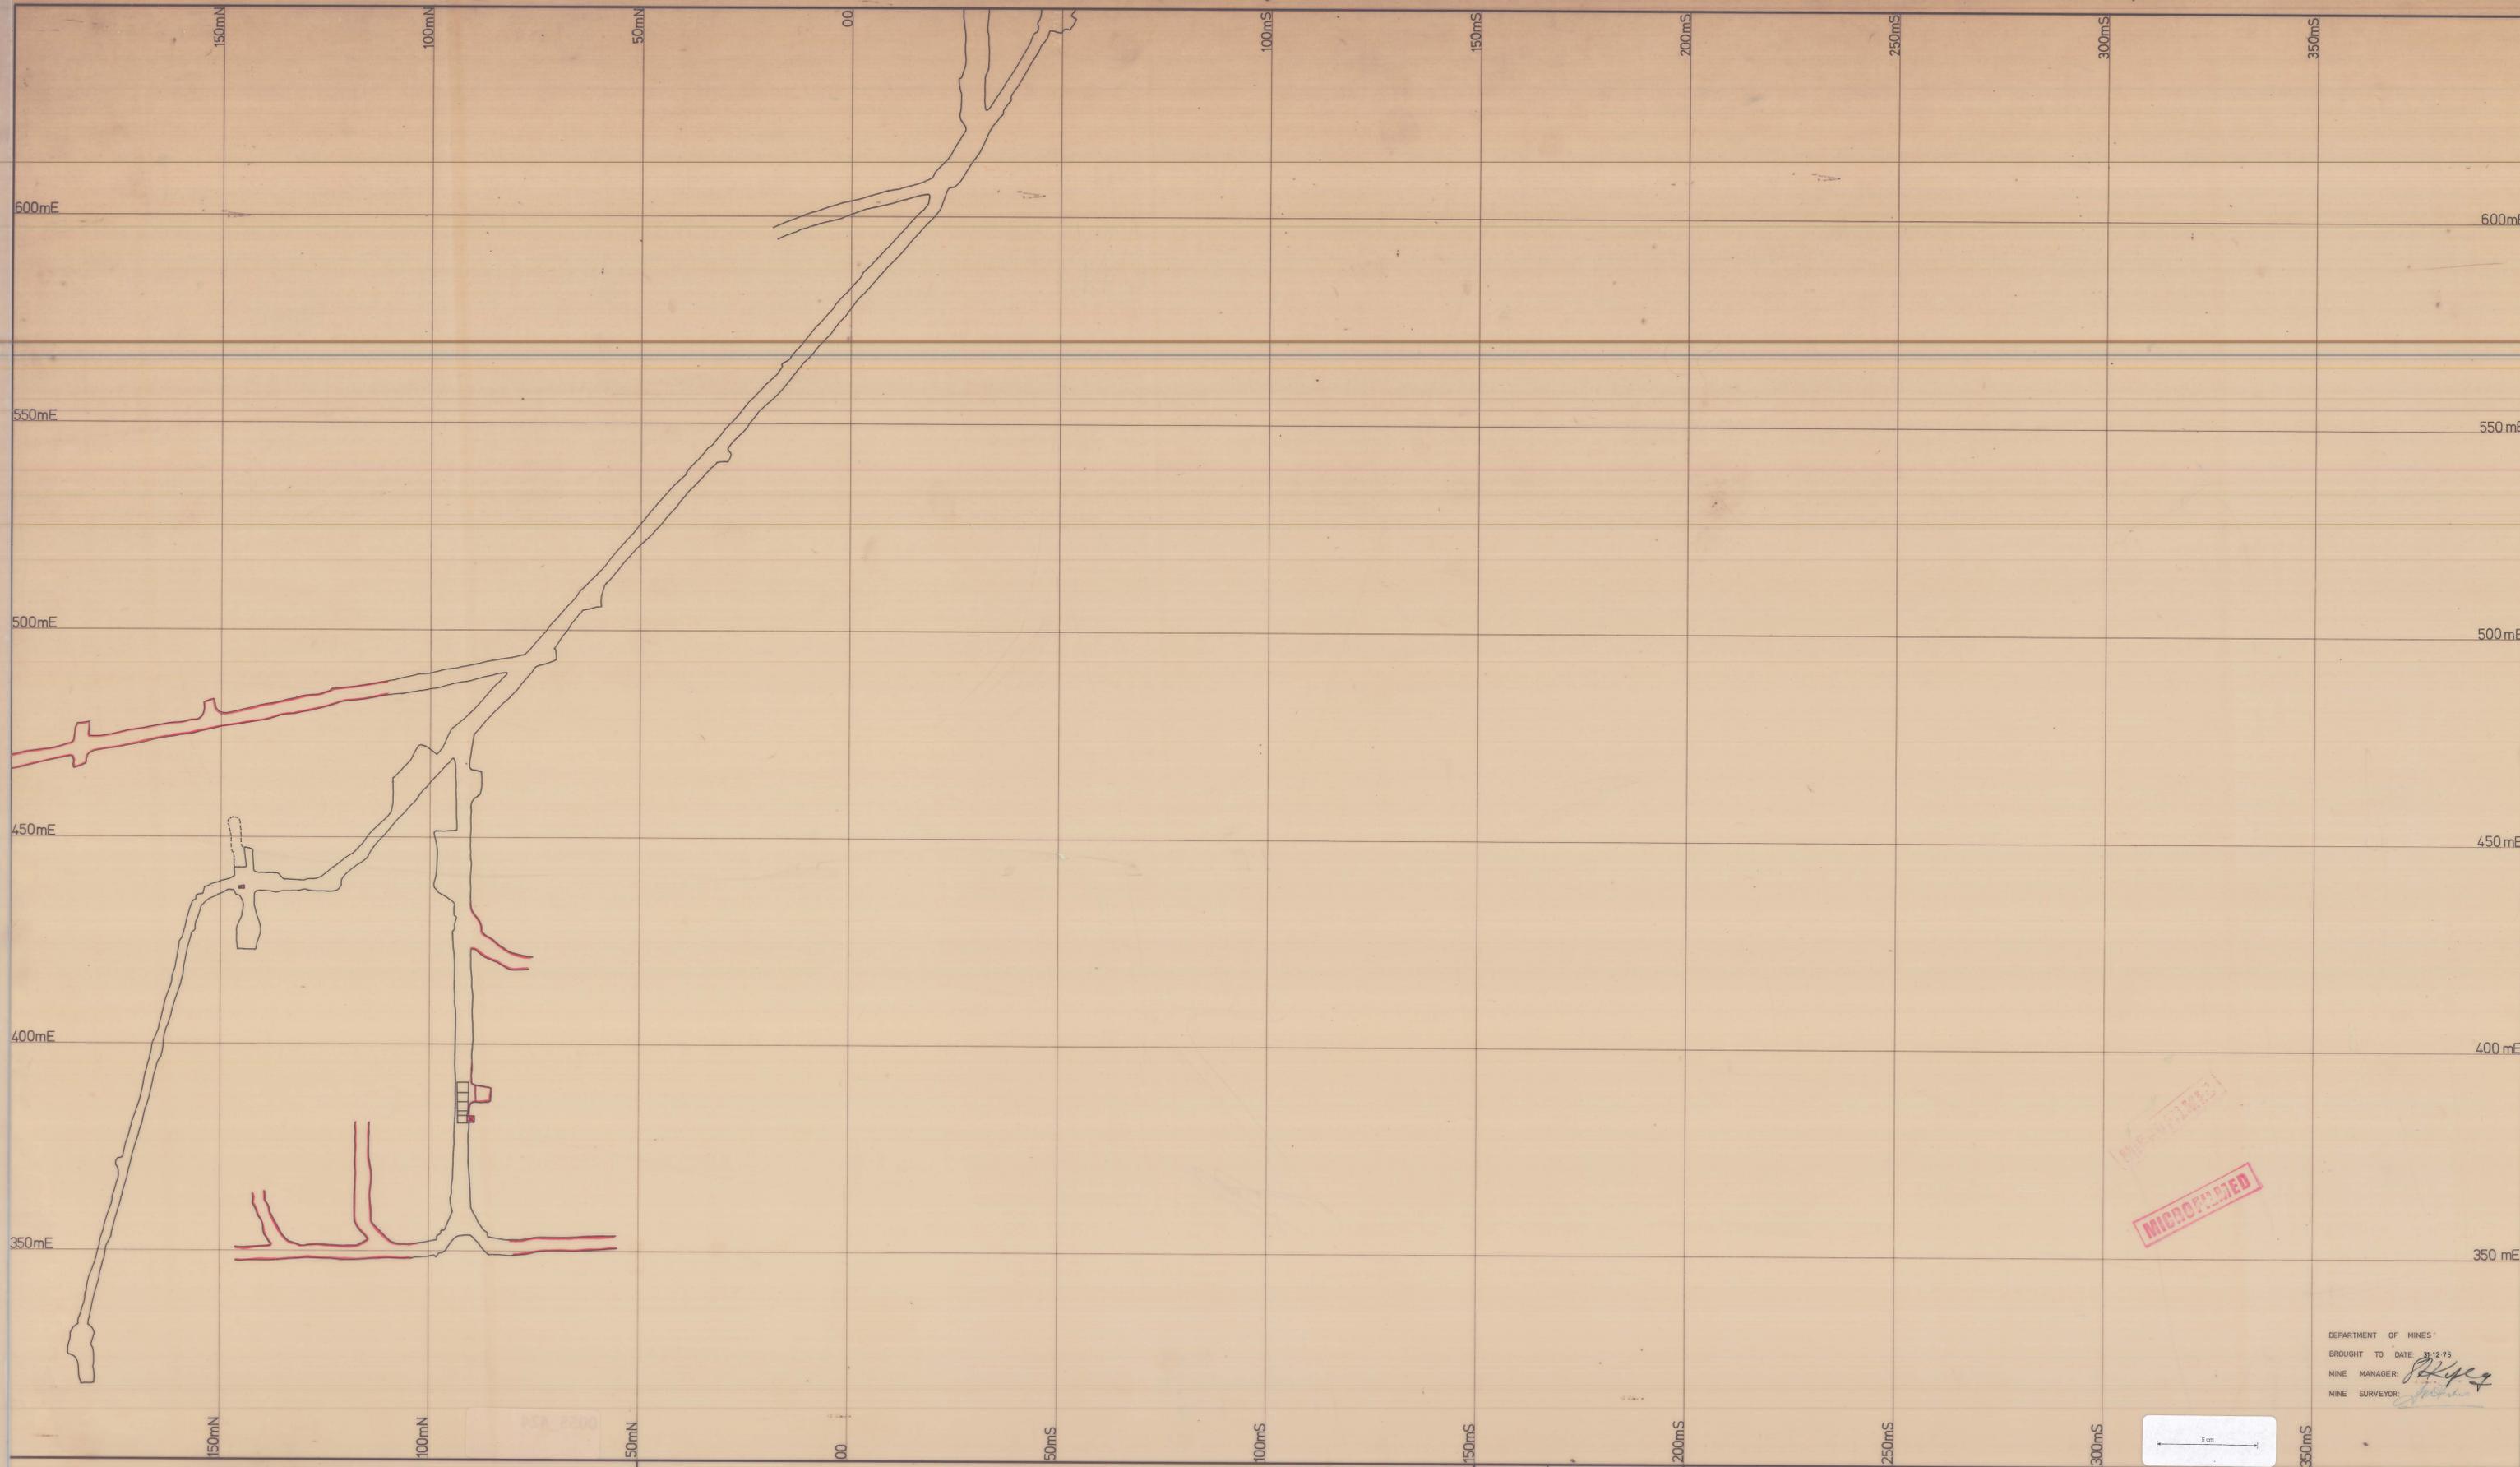

MICROFILMED

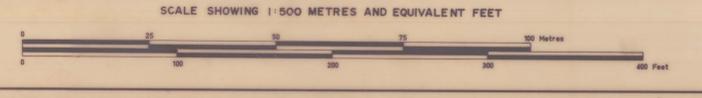

ELECTROLYTIC ZINC COMPANY OF AUSTRALASIA LIMITED
WEST COAST MINES, TAS.

SURVEY BY		SCALE	1: 500
DRAWN BY		DATE	1975
TRACED BY	R.J.R.	REFERENCE	

ROSEBERY MINE
No 17 LEVEL ①

DEPARTMENT OF MINES
BROUGHT TO DATE: 3.12.75
MINE MANAGER: *[Signature]*
MINE SURVEYOR: *[Signature]*

DRAWING No: *[Symbol]*
76272