



0055-426

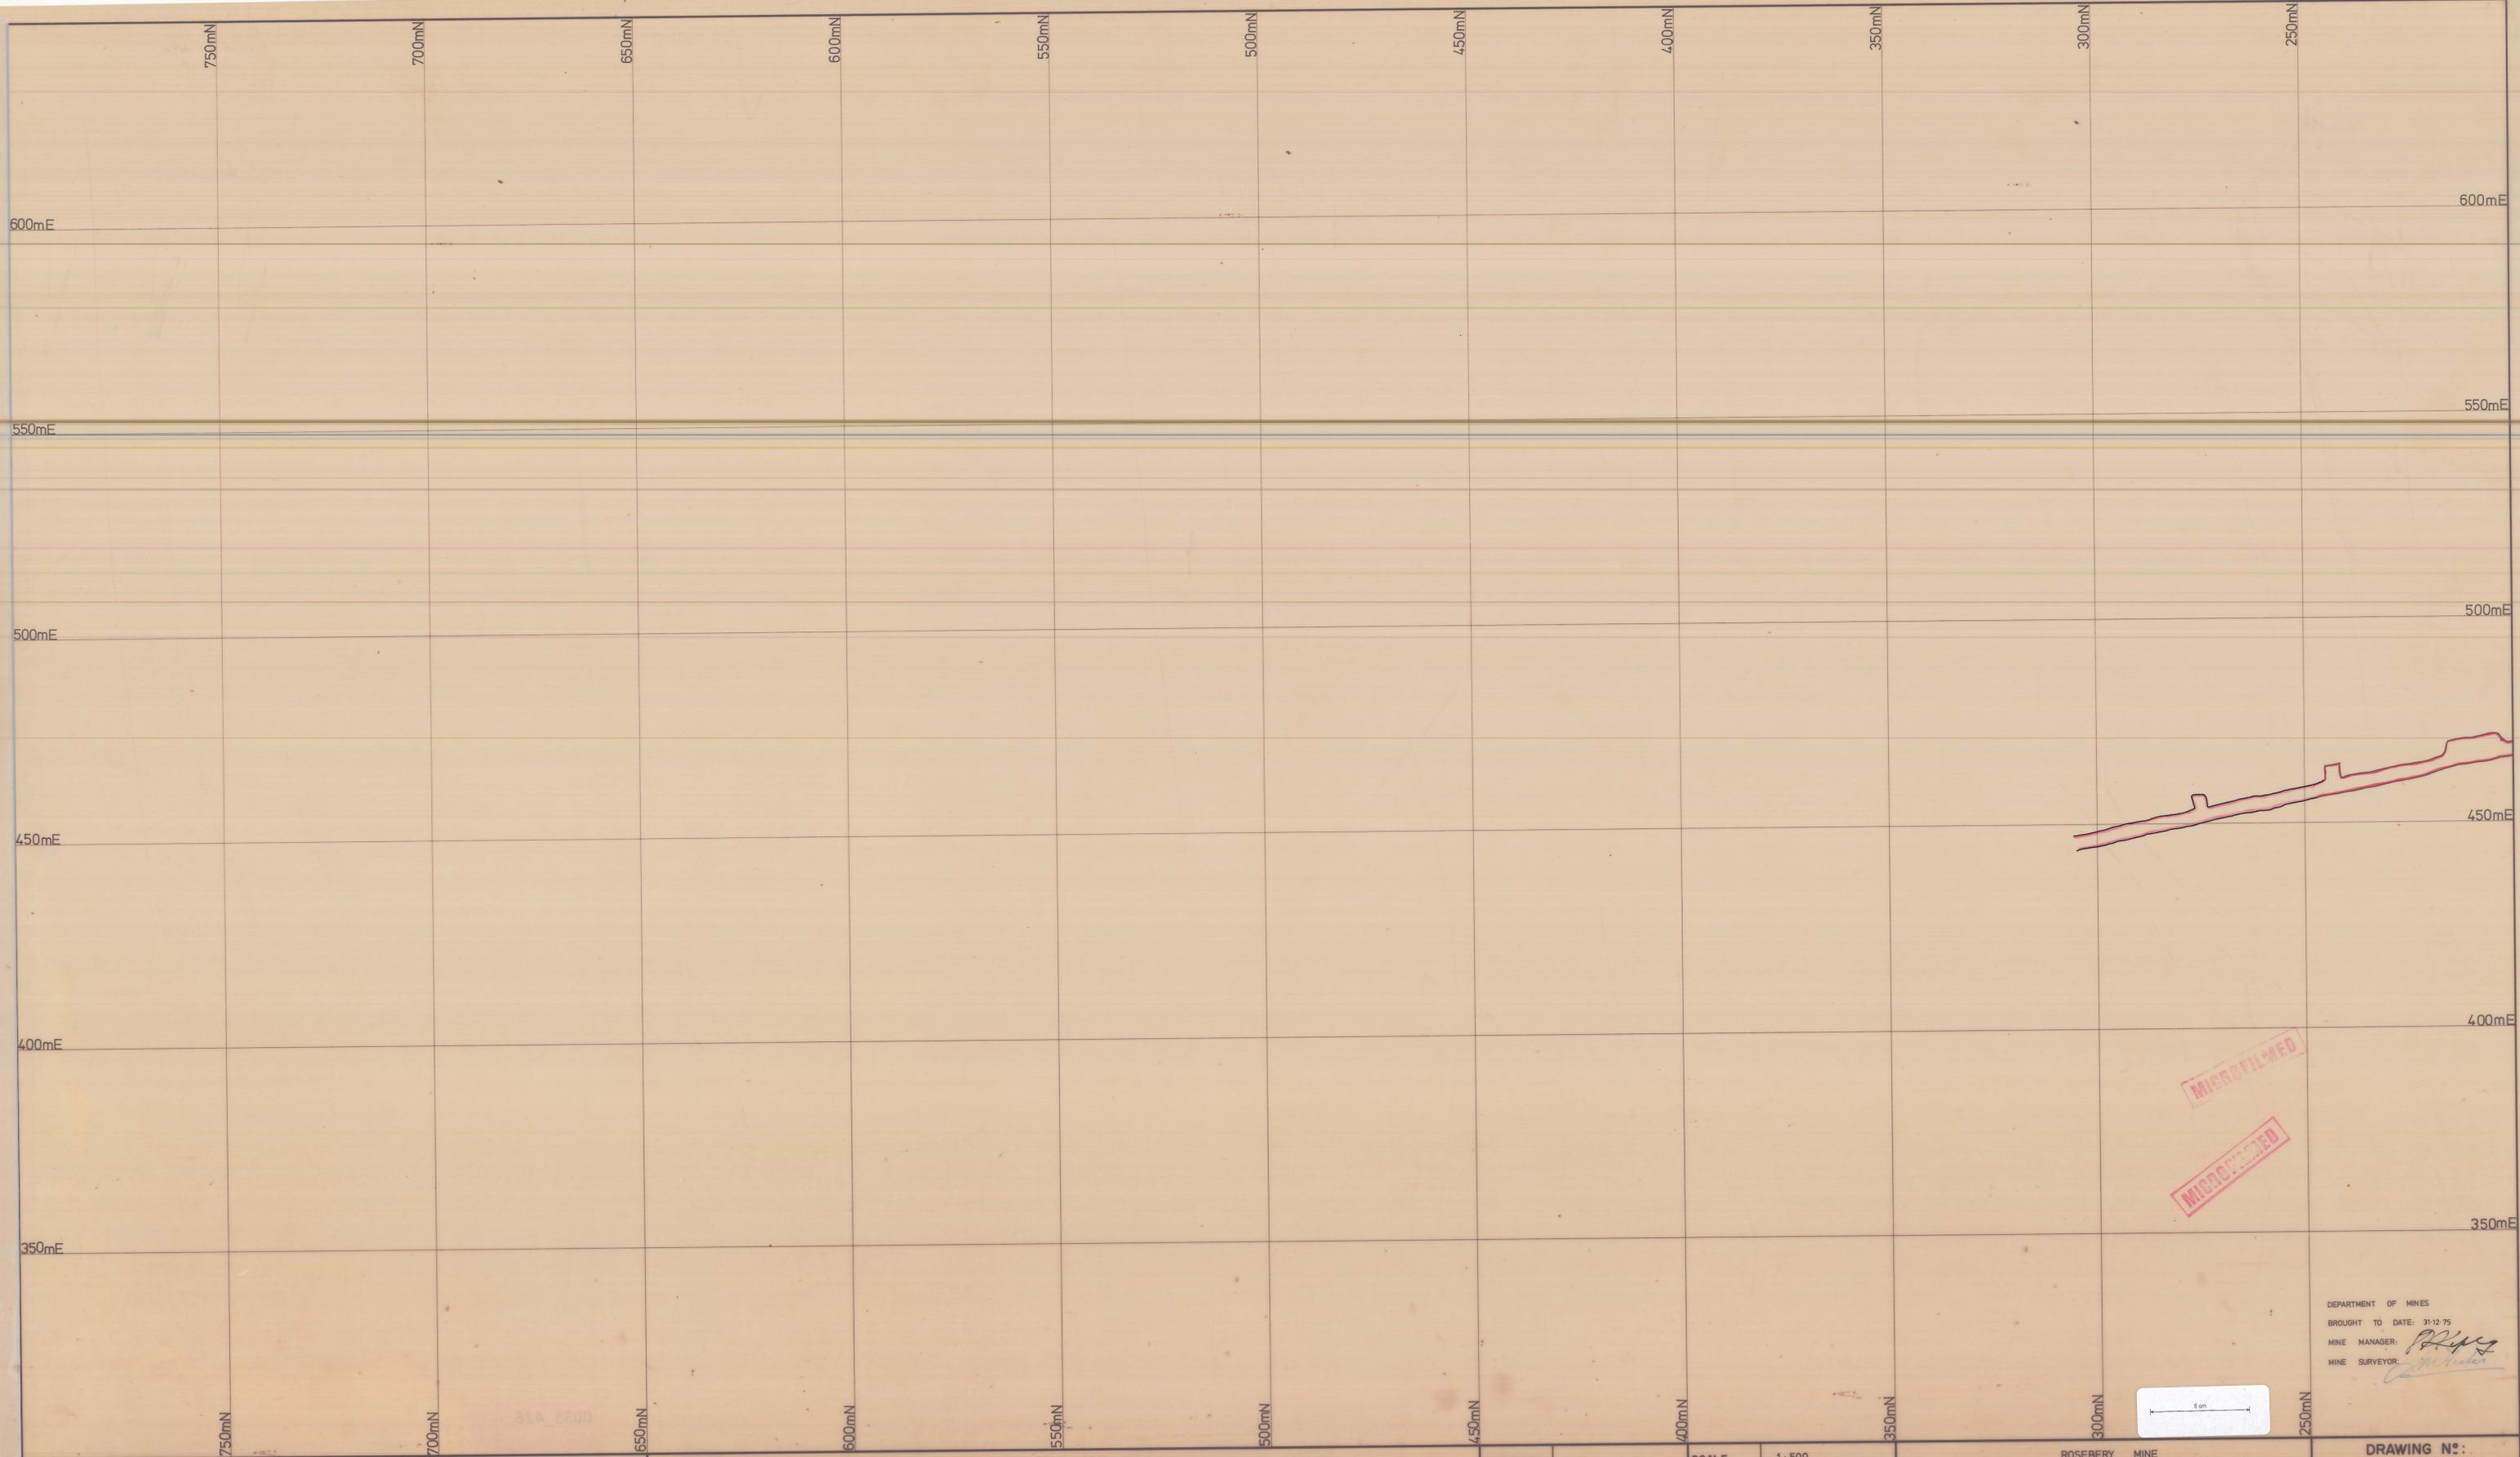


MICROFILMED

MICROFILMED

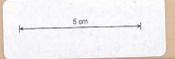

DEPARTMENT OF MINES  
 BROUGHT TO DATE: 31.12.75  
 MINE MANAGER: *[Signature]*  
 MINE SURVEYOR: *[Signature]*

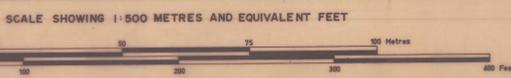

ELECTROLYTIC ZINC COMPANY OF AUSTRALASIA LIMITED  
 WEST COAST MINES, T.A.S.

SURVEY BY		SCALE	1: 500
DRAWN BY		DATE	1975
TRACED BY	I.T.M.	REFERENCE	

ROSEBERRY MINE  
 N° 17 LEVEL (3)

DRAWING N°:  
 ②  
 ①  
 ③

76012