



0055\_427

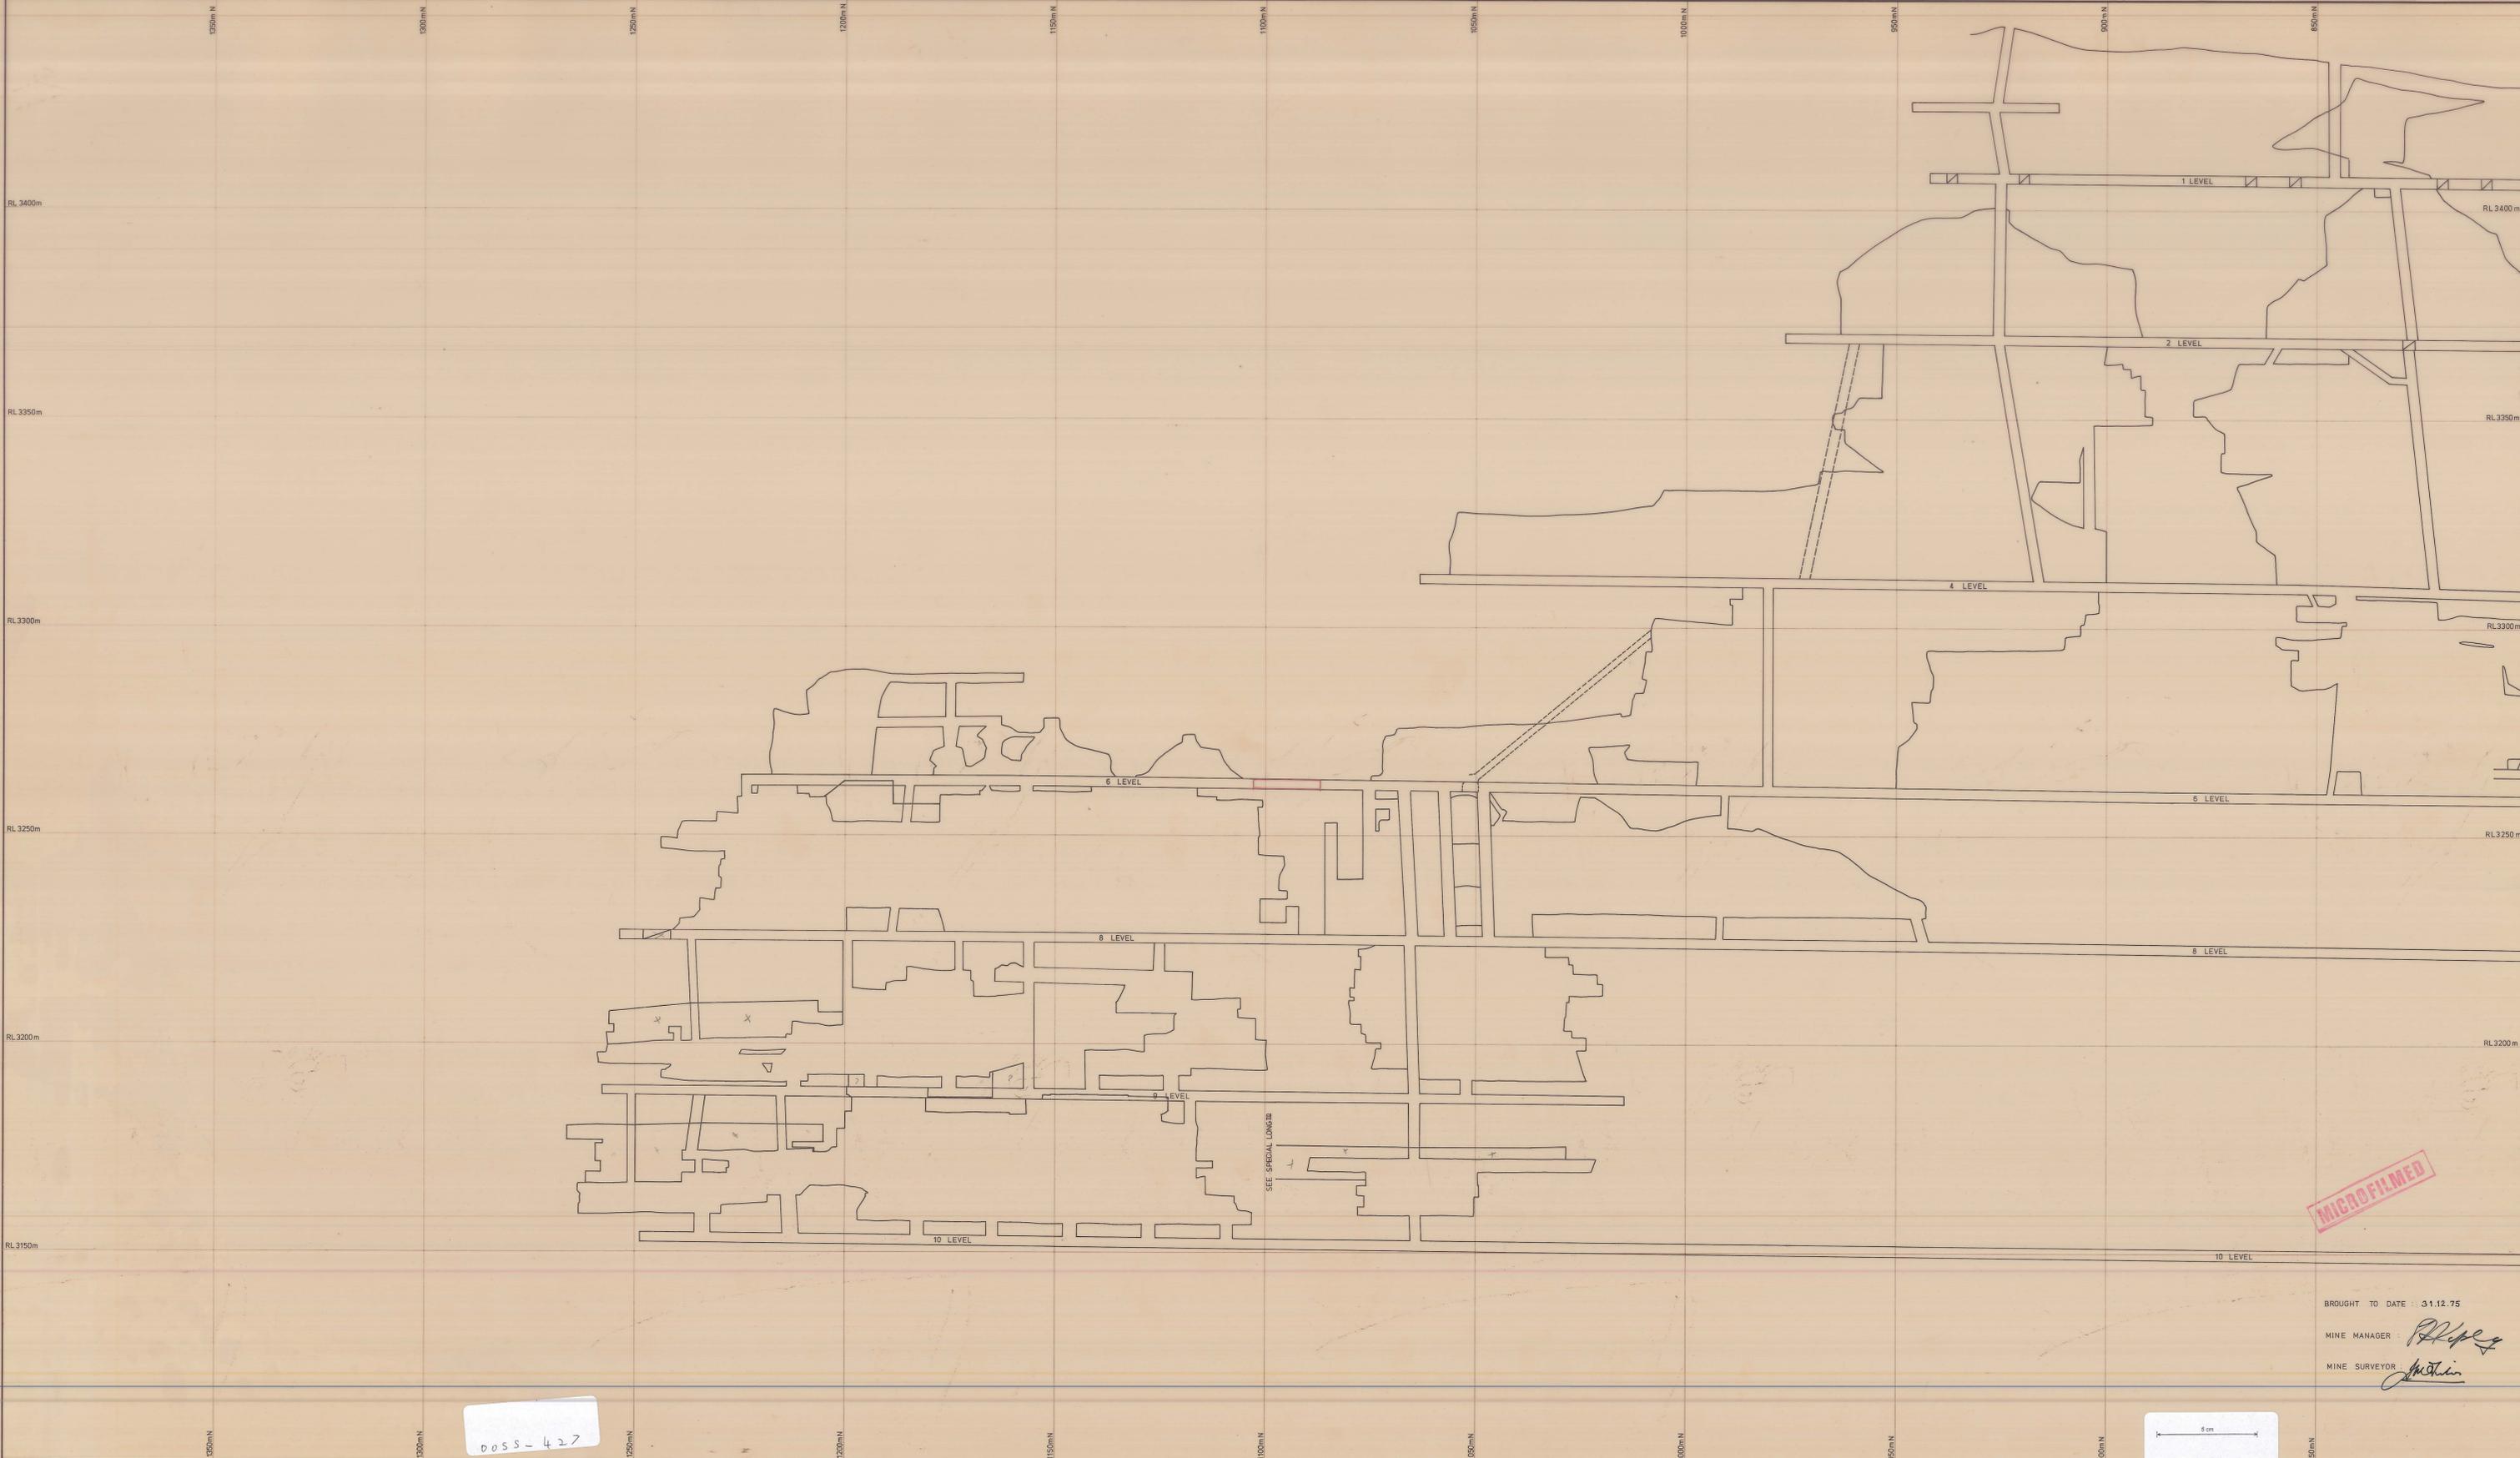

MICROFILMED

BROUGHT TO DATE : 31.12.75  
 MINE MANAGER : *[Signature]*  
 MINE SURVEYOR : *[Signature]*

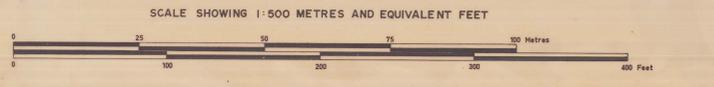

0055-427

ELECTROLYTIC ZINC COMPANY OF AUSTRALASIA LIMITED  
 WEST COAST MINES, TAS.

SURVEY BY		SCALE	1 : 500
DRAWN BY		DATE	1973
TRACED BY	P.J. Lowe	REFERENCE	

ROSEBERY MINE  
 LONGITUDINAL PROJECTION  
 NORTH END — ABOVE 10/L.

DRAWING N° :  
 DEPARTMENT OF MINES  
 78073