



0055_428

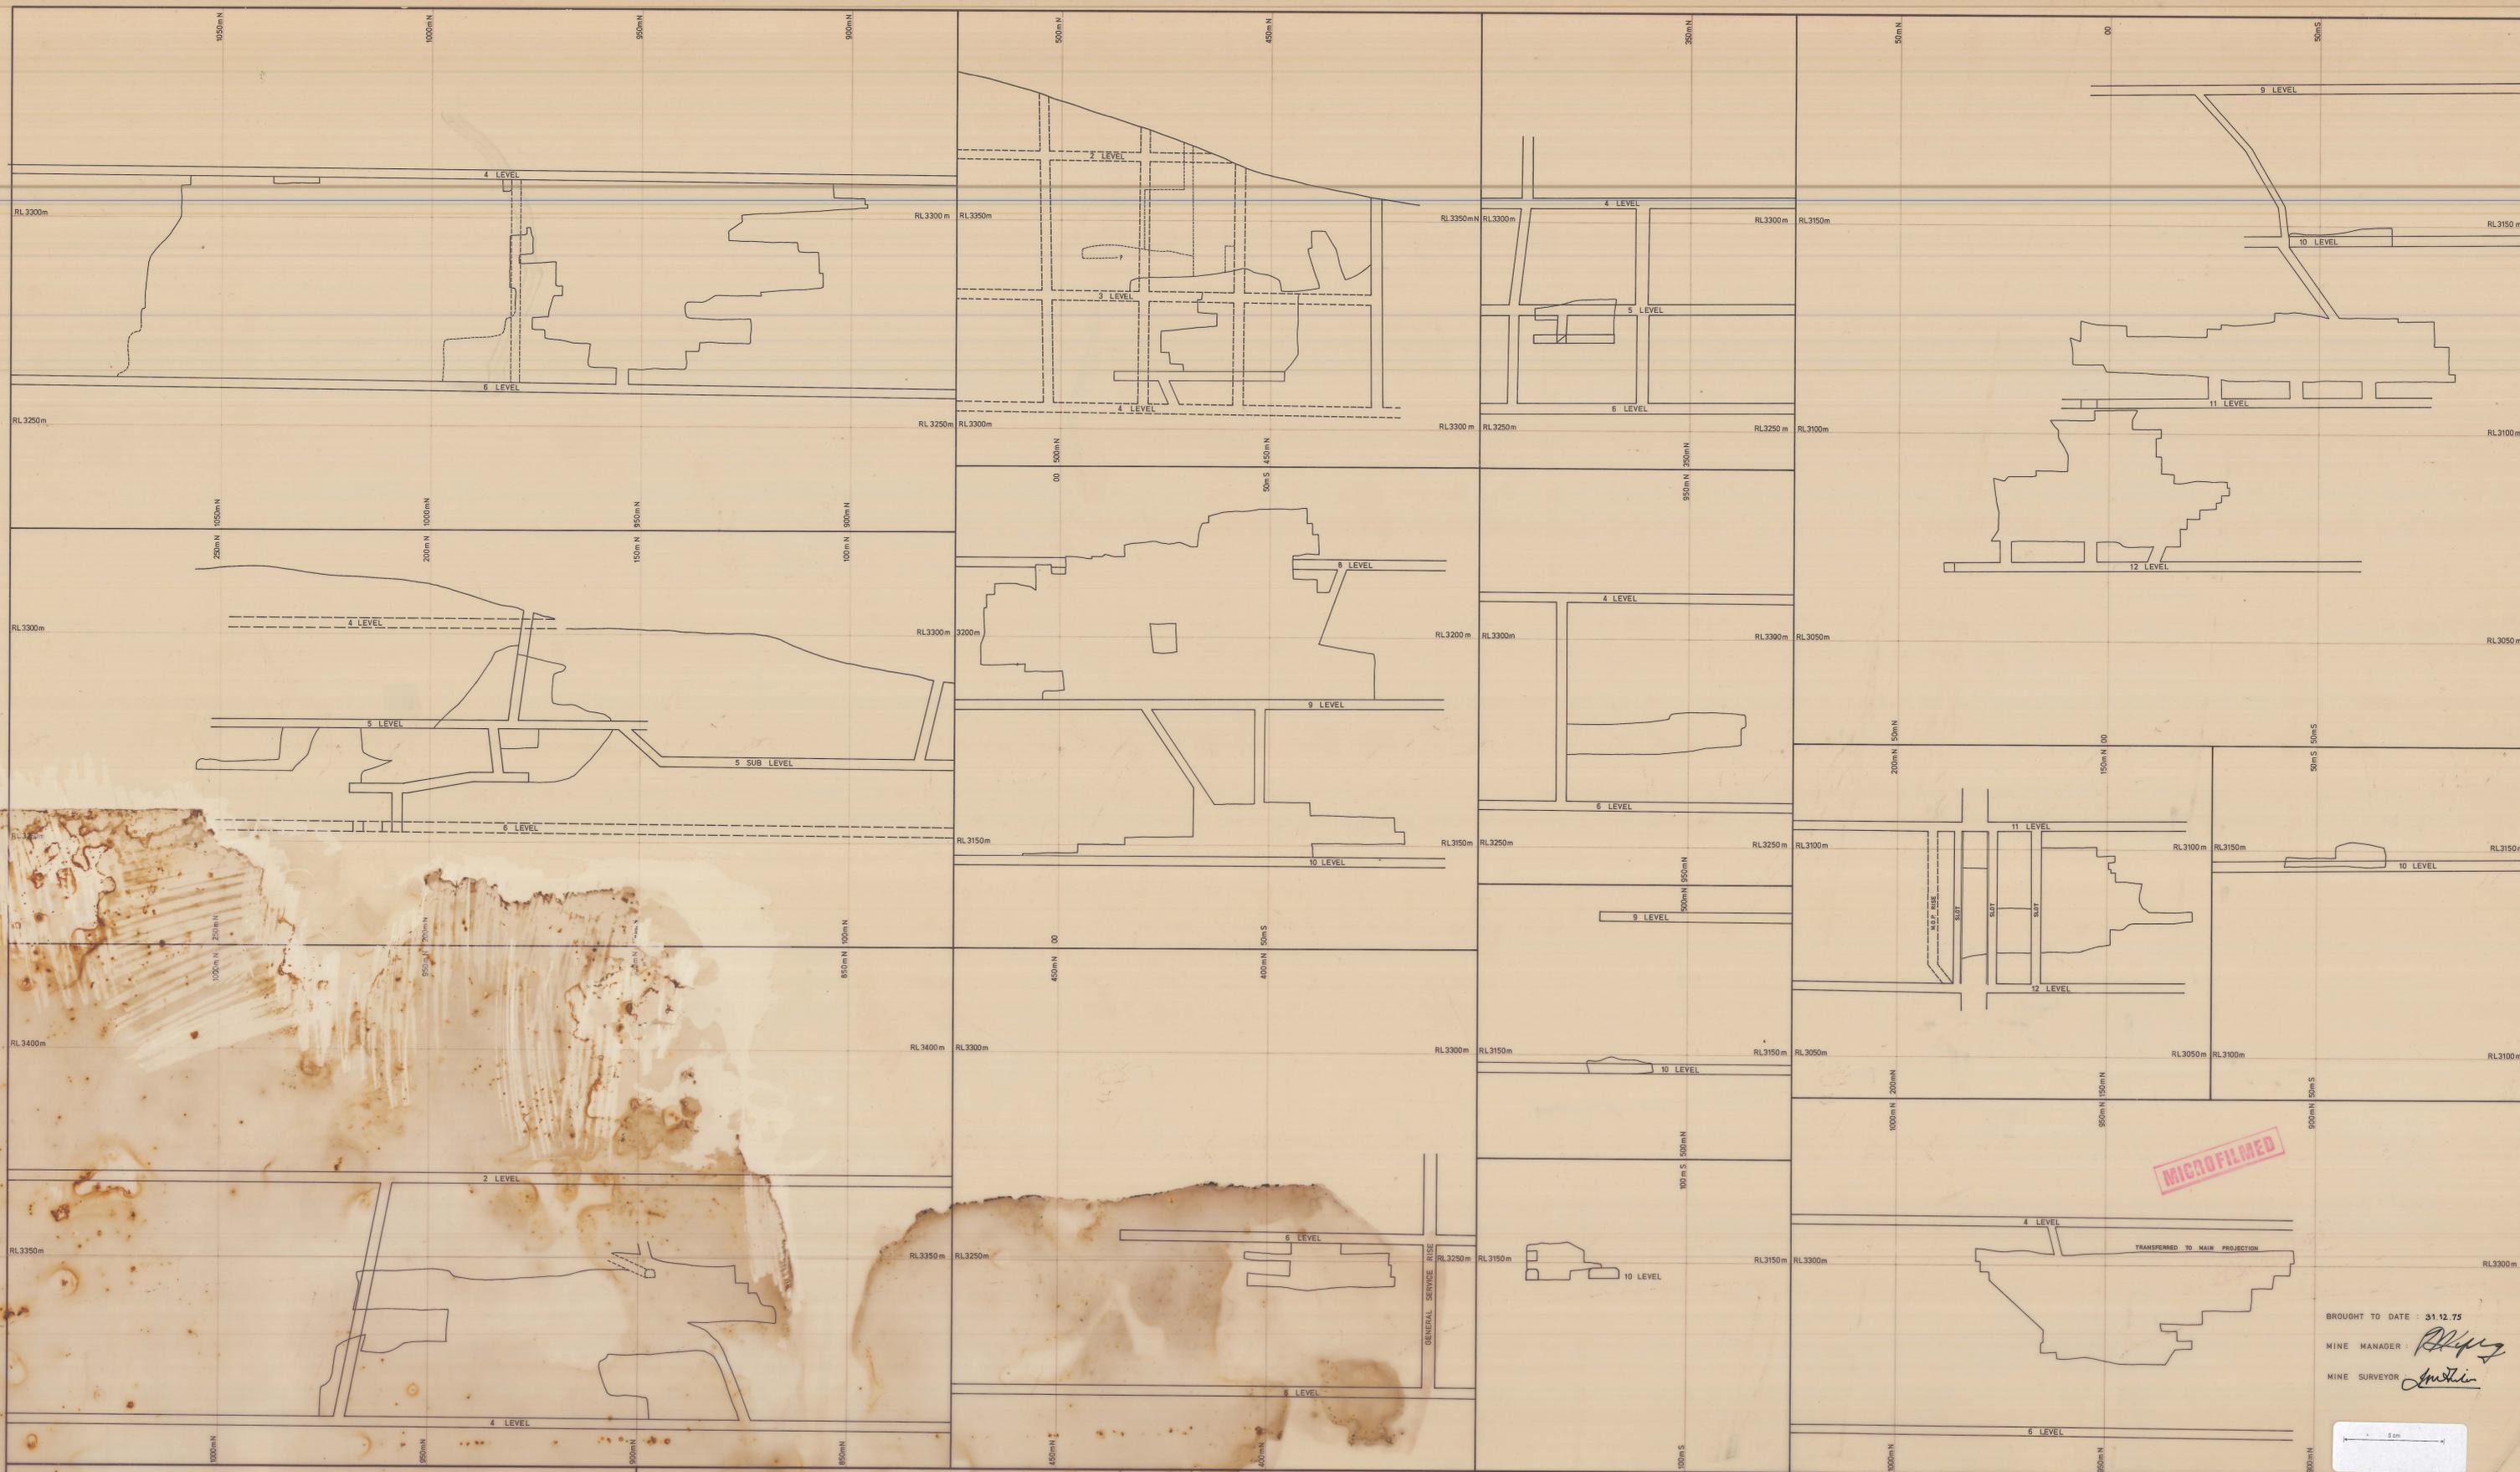

MICROFILMED

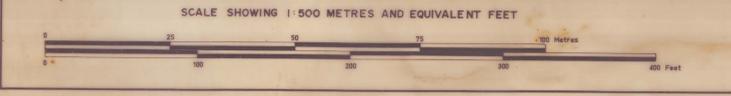

0055_428

ELECTROLYTIC ZINC COMPANY OF AUSTRALASIA LIMITED
WEST COAST MINES, T.A.S.

SURVEY BY		SCALE	1 : 500
DRAWN BY		DATE	1973
TRACED BY	P. J. Lowe	REFERENCE	

ROSEBERY MINE
LONGITUDINAL PROJECTION
SPECIFIC STOPES

BROUGHT TO DATE : 31.12.75
MINE MANAGER : *[Signature]*
MINE SURVEYOR : *[Signature]*

DRAWING NO :
DEPARTMENT OF MINES

