


0055\_430

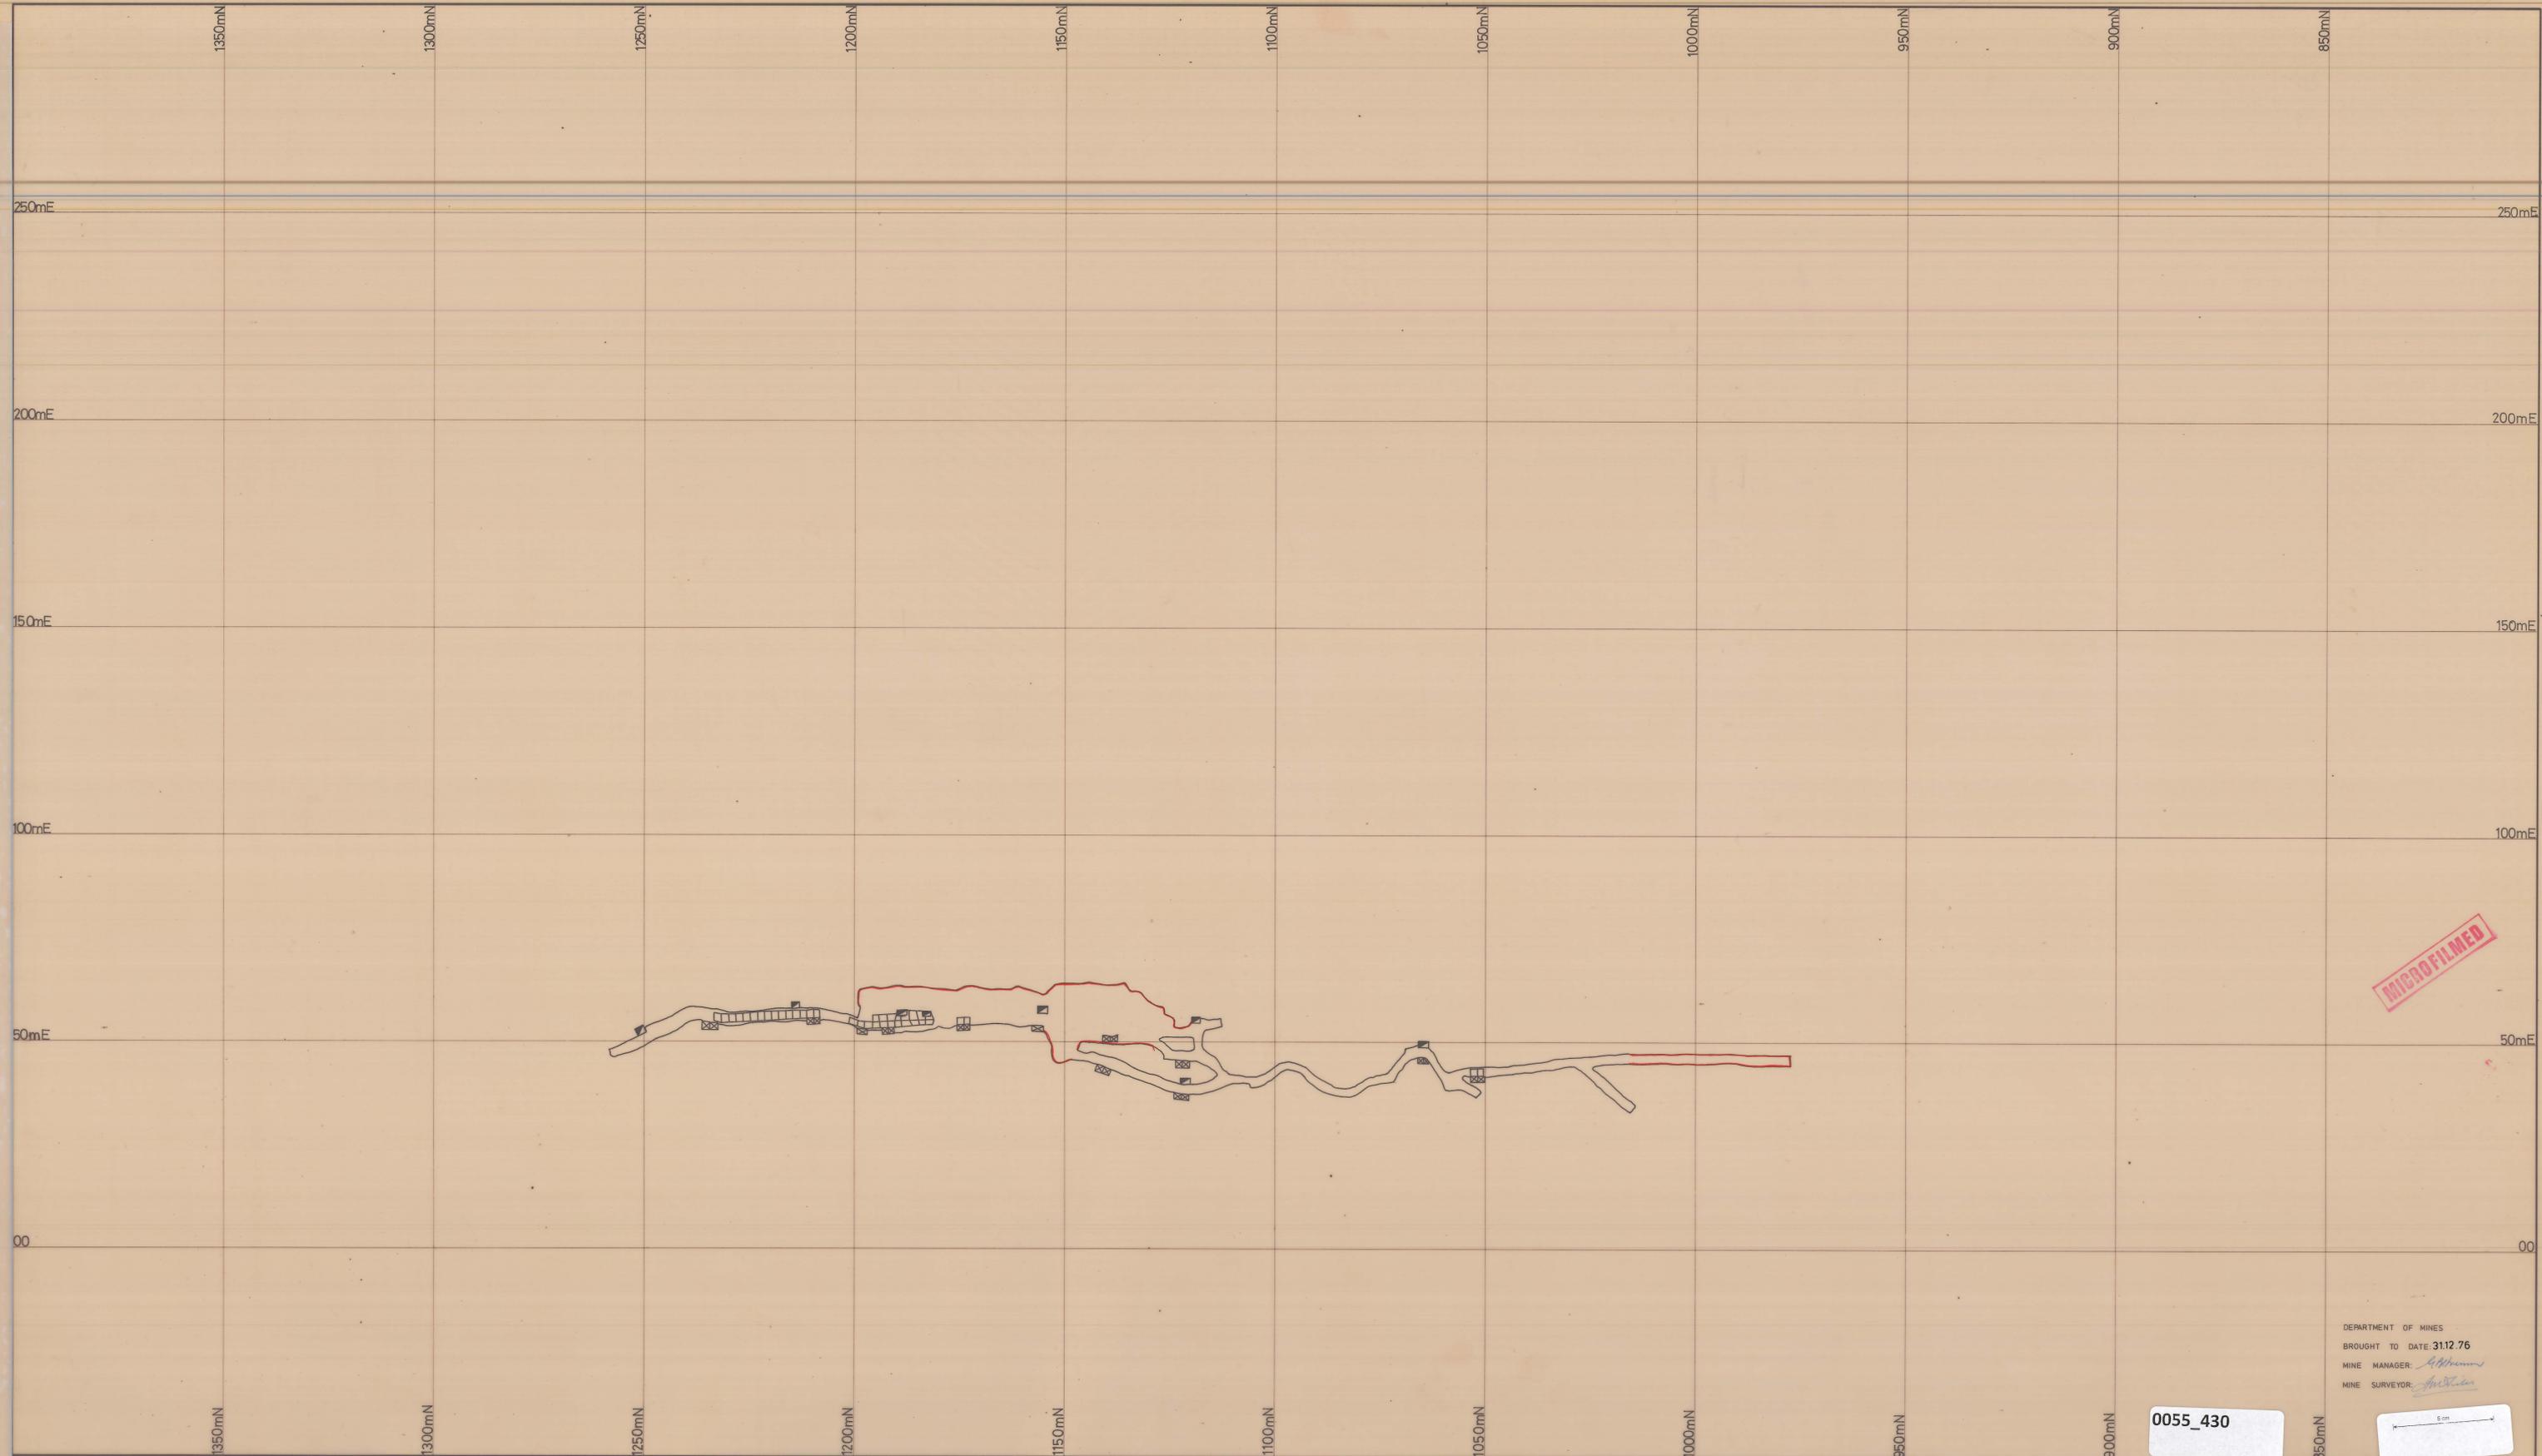

MICROFILMED

DEPARTMENT OF MINES  
 BROUGHT TO DATE 31.12.76  
 MINE MANAGER *A. Williams*  
 MINE SURVEYOR *M. Stiles*

0055\_430



ELECTROLYTIC ZINC COMPANY OF AUSTRALASIA LIMITED  
 WEST COAST MINES, T.A.S.

SURVEY BY		SCALE	1:500
DRAWN BY		DATE	1975
TRACED BY	RJR	REFERENCE	

ROSEBERY MINE  
 No 9 LEVEL ①

DRAWING No: ① ② ③

7/1007