



0055_431

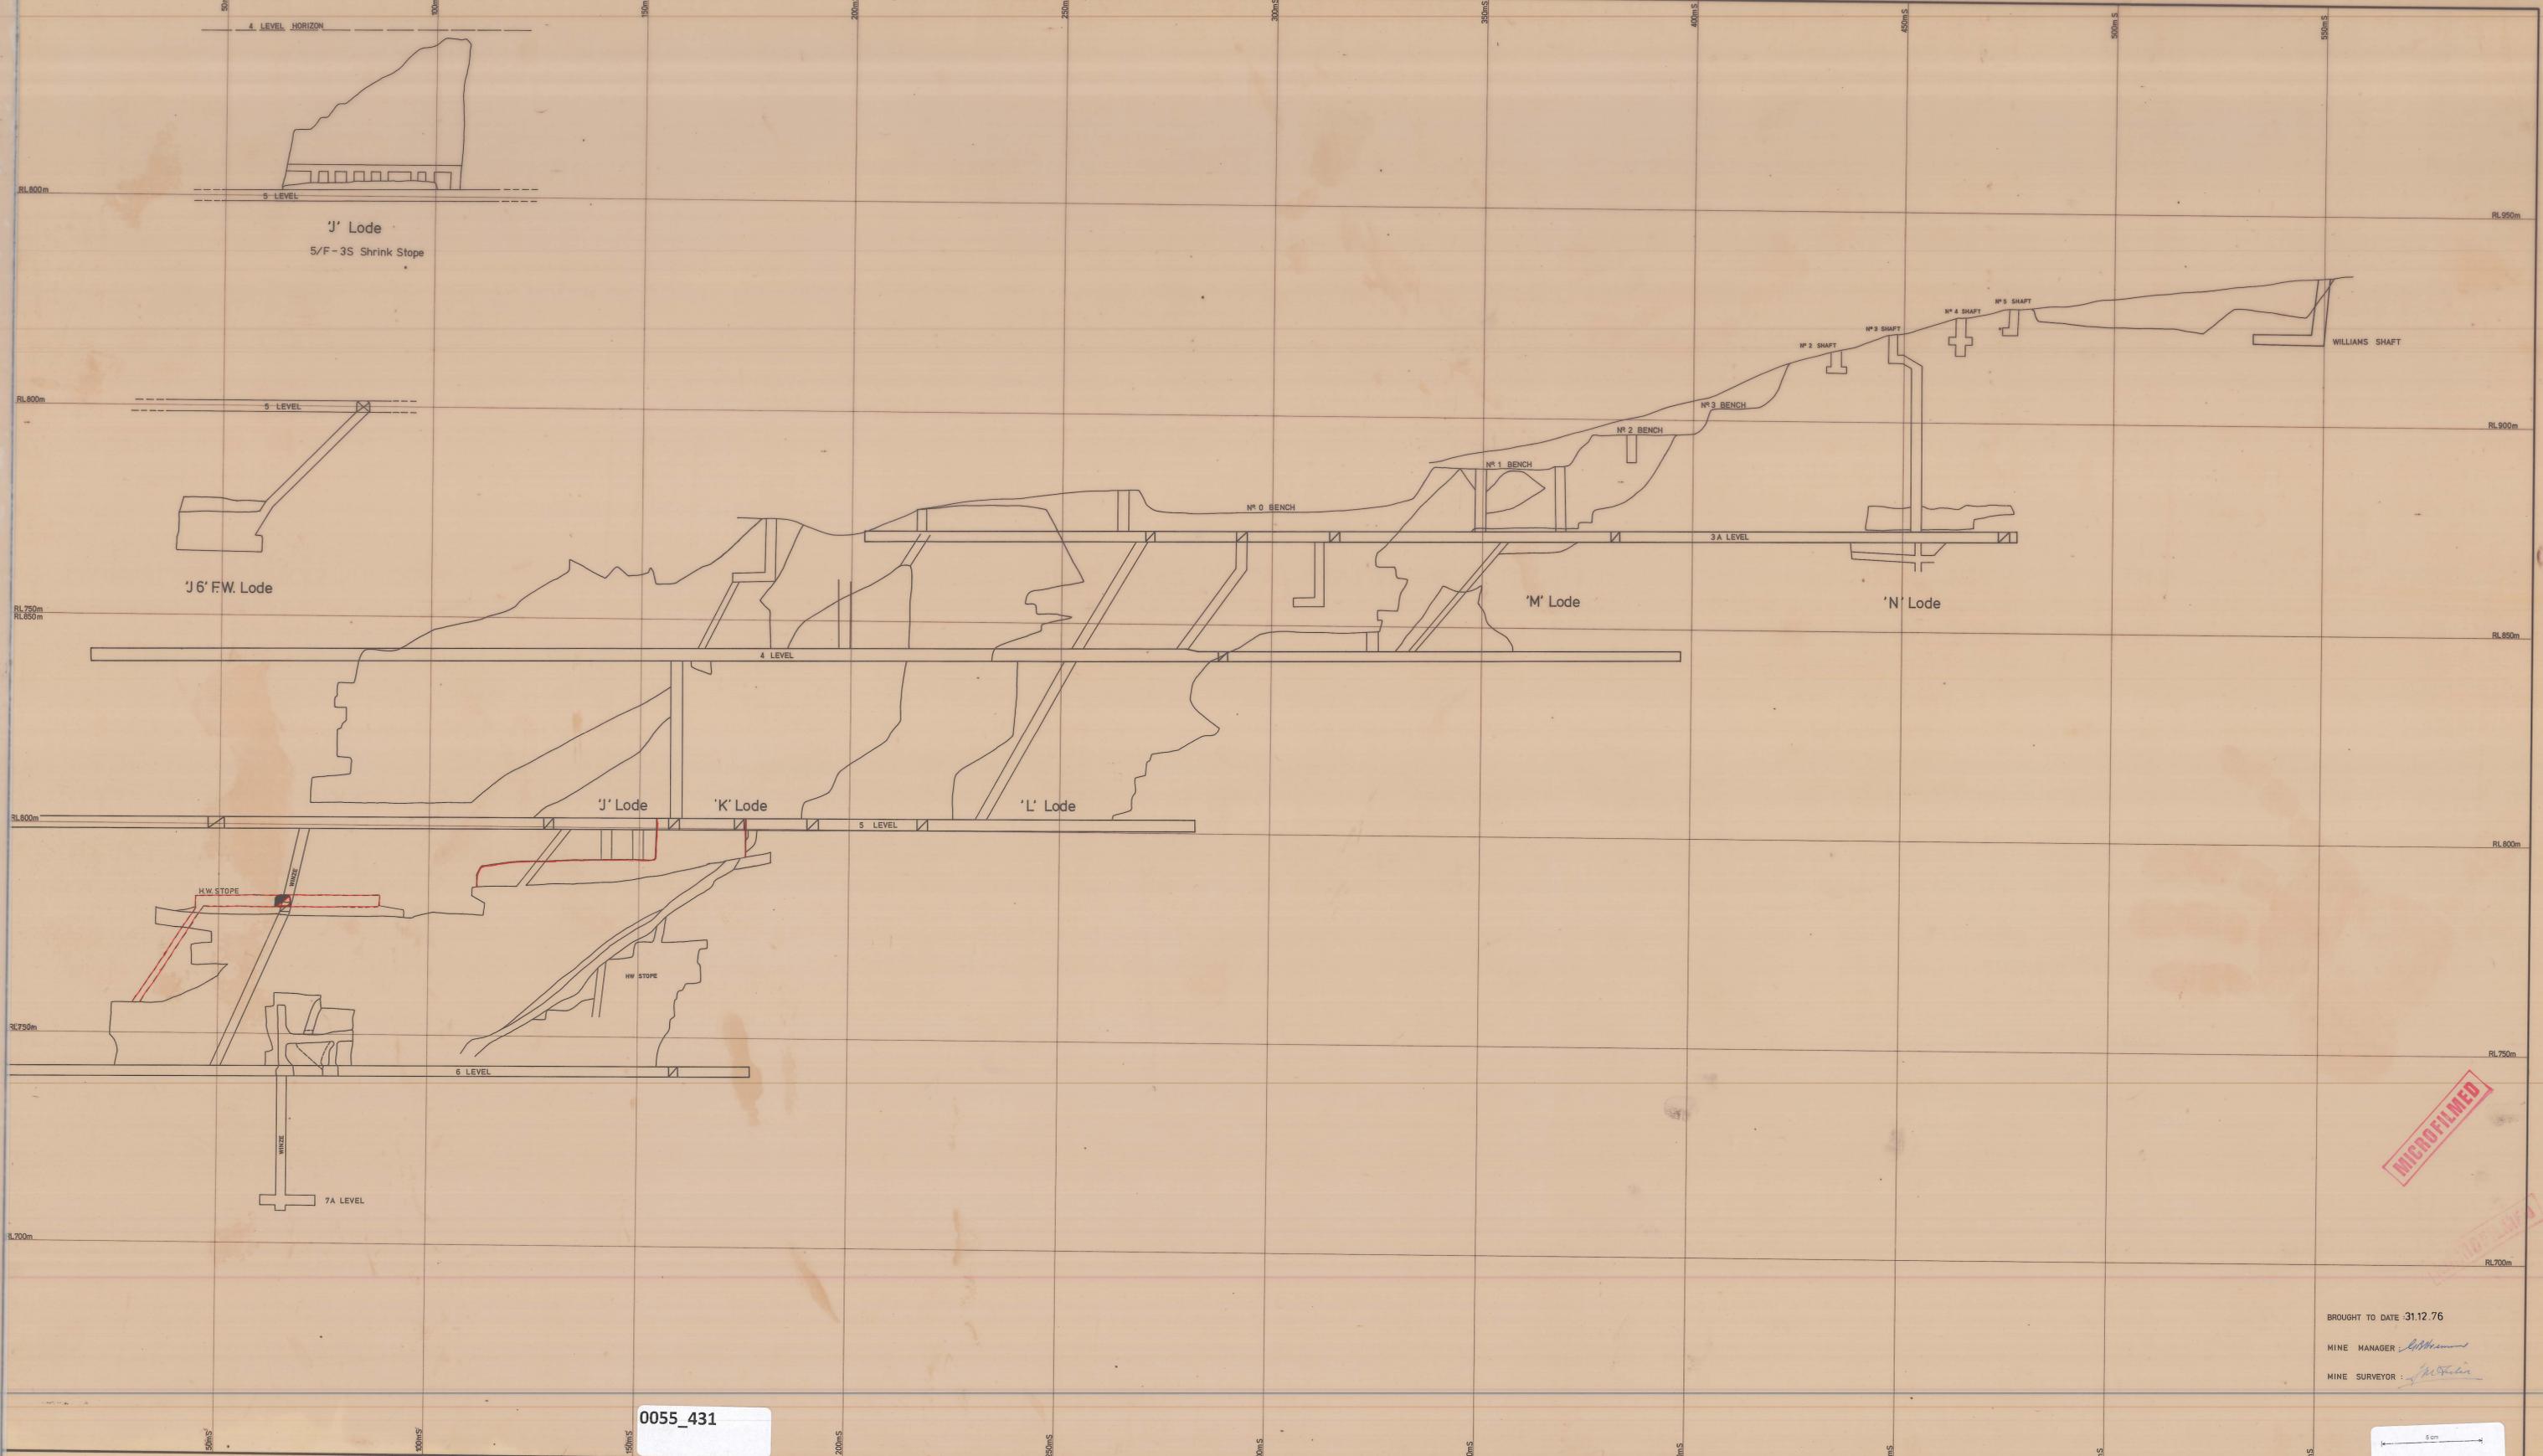

MICROFILMED

BROUGHT TO DATE 31.12.76
 MINE MANAGER *[Signature]*
 MINE SURVEYOR *[Signature]*

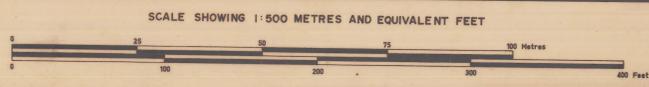


0055_431

ELECTROLYTIC ZINC COMPANY OF AUSTRALASIA LIMITED
 WEST COAST MINES, T.A.S.

SURVEY BY		SCALE	1 : 500
DRAWN BY		DATE	1973
TRACED BY	P.J. Lowe	REFERENCE	

HERCULES MINE
 LONGITUDINAL PROJECTION

DRAWING N°:
 DEPARTMENT OF MINES

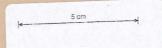

71003