


MICROFILMED

BROUGHT TO DATE : 31.12.75
 MINE MANAGER : *[Signature]*
 MINE SURVEYOR : *[Signature]*



0055_432

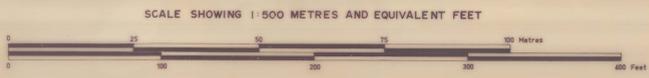

ELECTROLYTIC ZINC COMPANY OF AUSTRALASIA LIMITED
 WEST COAST MINES, T.A.S.

SURVEY BY		SCALE	1 : 500
DRAWN BY		DATE	1973
TRACED BY	P.J. Lowe	REFERENCE	

HERCULES MINE
 LONGITUDINAL PROJECTION

DRAWING N° :
 DEPARTMENT OF MINES
 76028

0055_432