
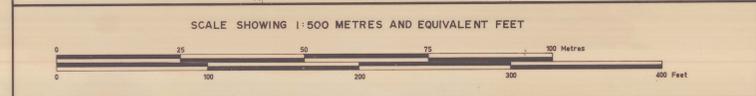


0055_434

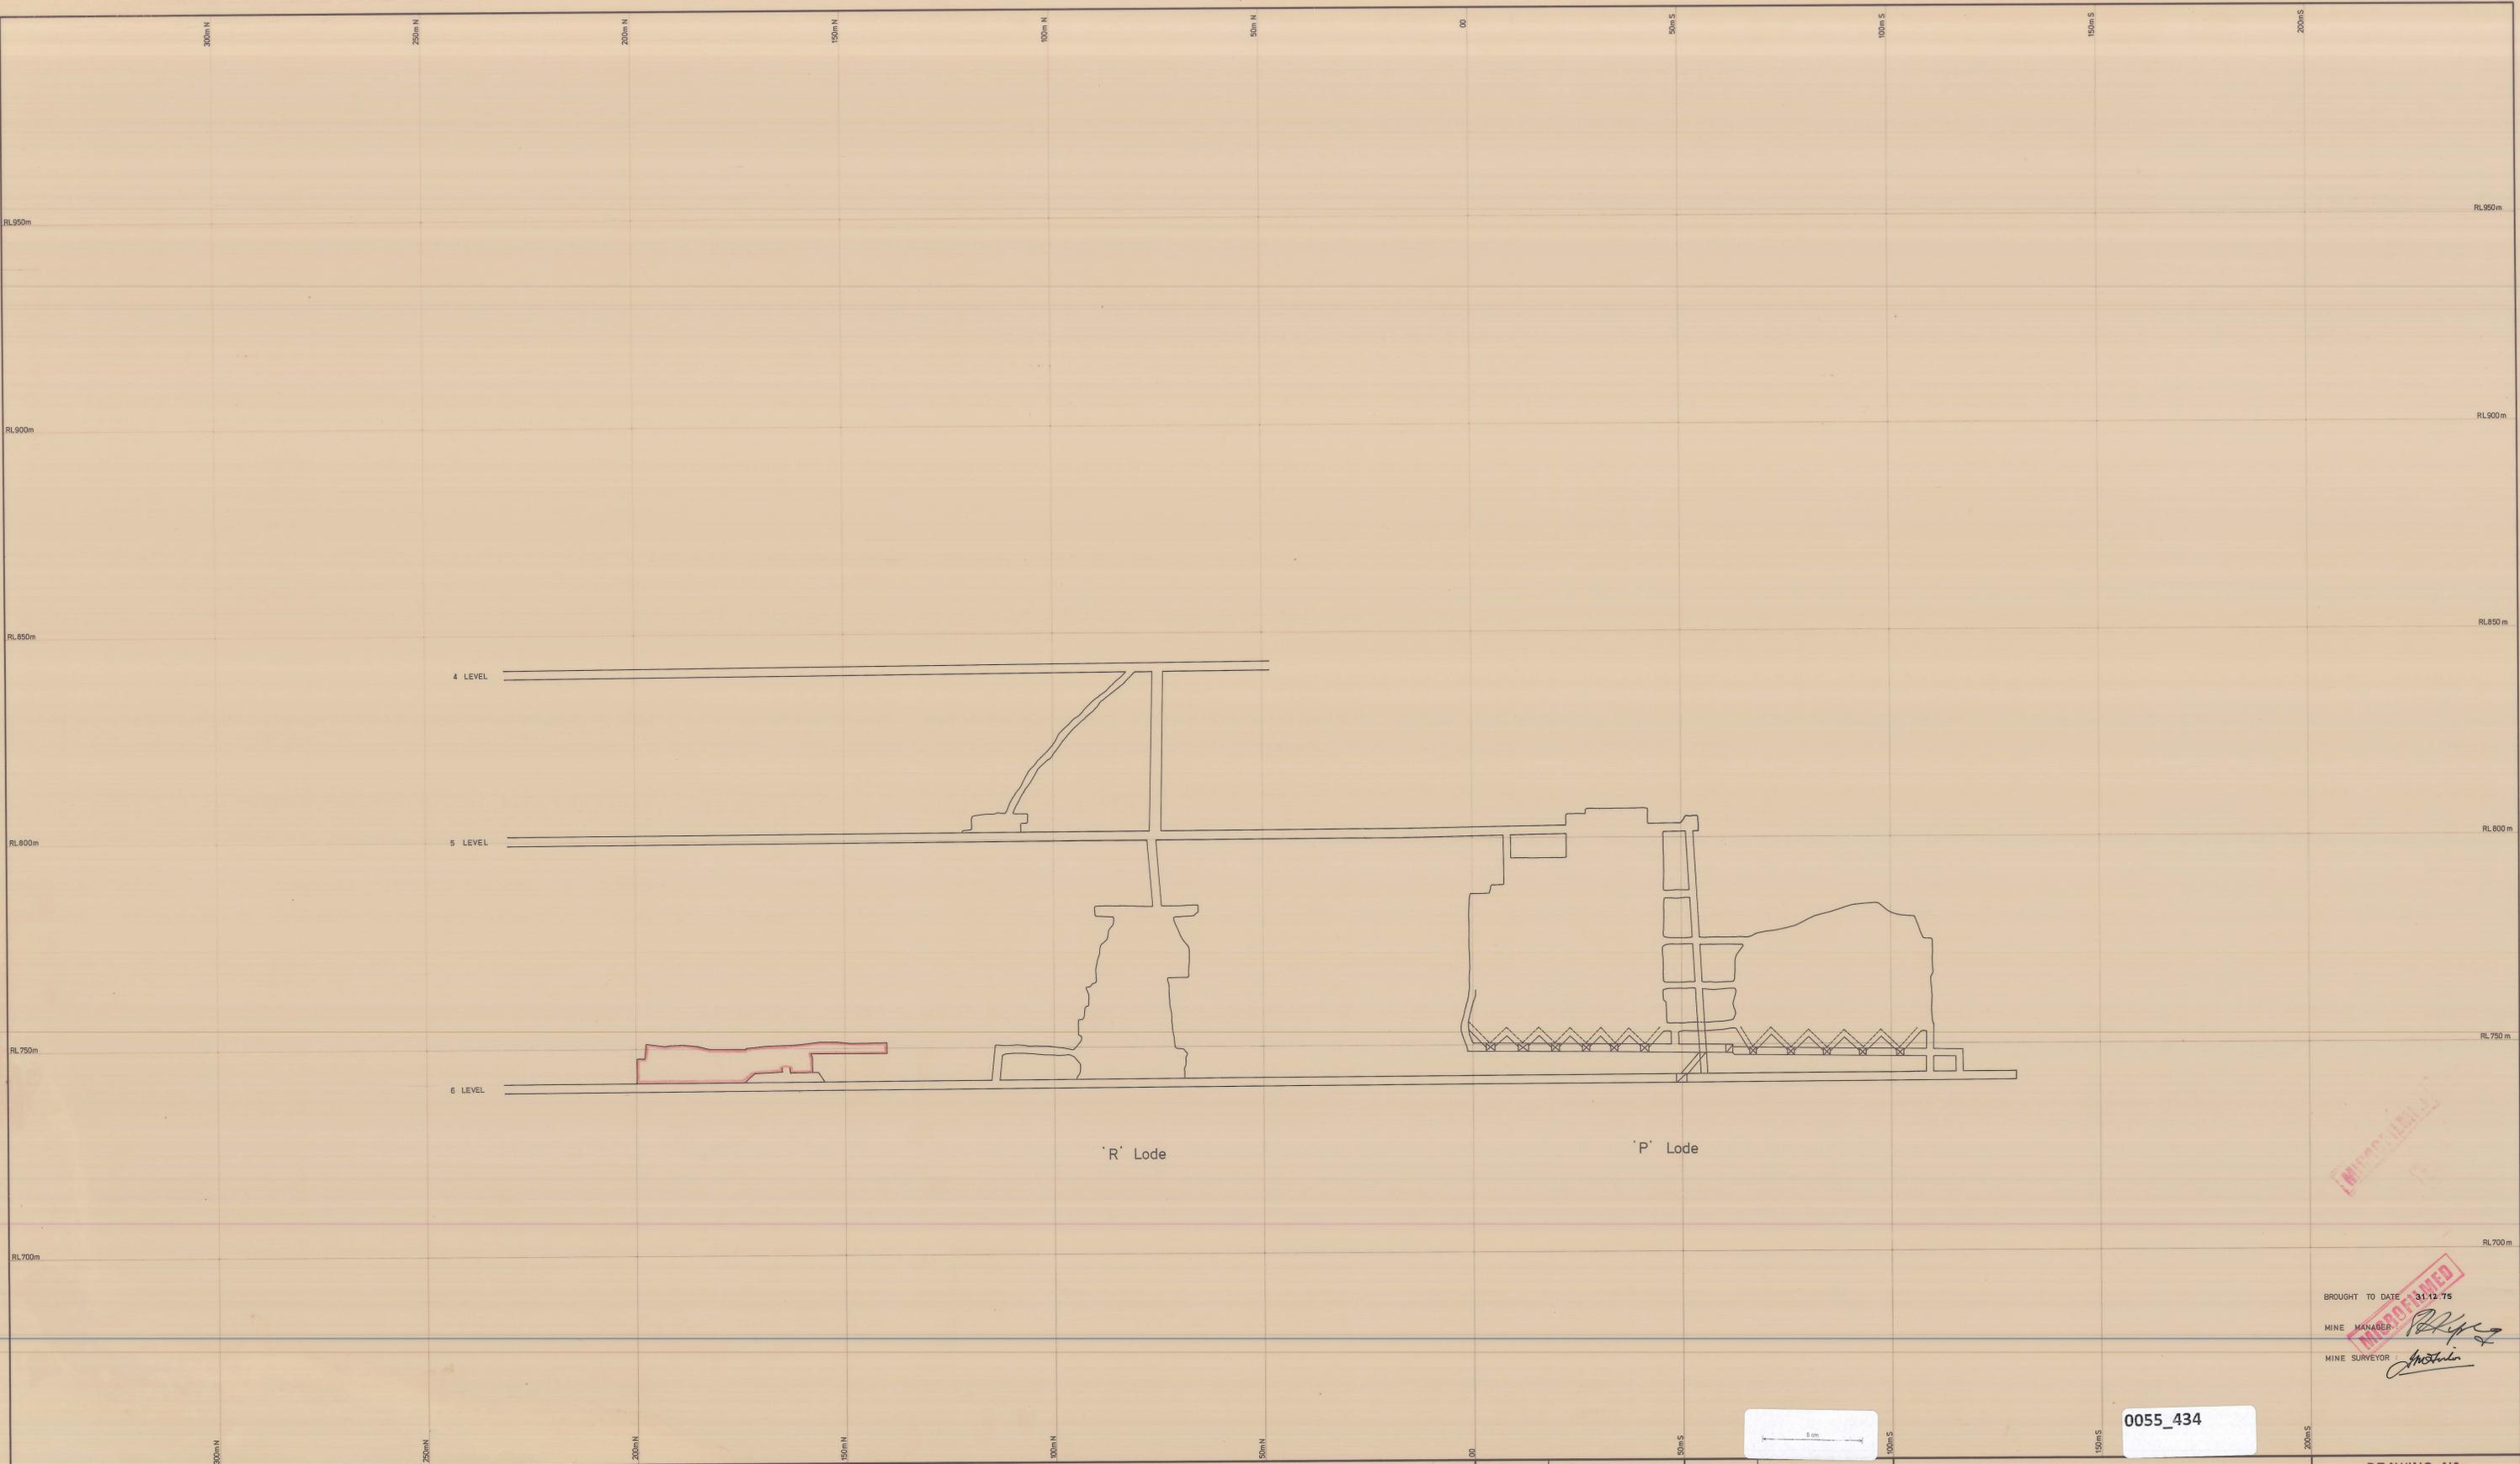

ELECTROLYTIC ZINC COMPANY OF AUSTRALASIA LIMITED
WEST COAST MINES, T.A.S.

SURVEY BY		SCALE	1 : 500
DRAWN BY		DATE	1973
TRACED BY	P.J. Lowe	REFERENCE	

HERCULES MINE
LONGITUDINAL PROJECTION

DRAWING N^o :
DEPARTMENT OF MINES
76026

BROUGHT TO DATE 31.12.75
MINE MANAGER *[Signature]*
MINE SURVEYOR *[Signature]*

0055_434

