


MICROFILMED

MICROFILMED

BROUGHT TO DATE: 31.12.75  
 MINE MANAGER: *[Signature]*  
 MINE SURVEYOR: *[Signature]*

0055\_435

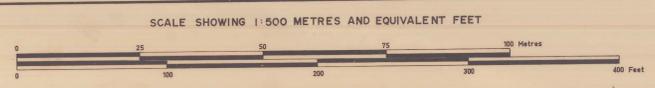

ELECTROLYTIC ZINC COMPANY OF AUSTRALASIA LIMITED  
 WEST COAST MINES, TAS.

SURVEY BY	SCALE	1 : 500
DRAWN BY	DATE	1973
TRACED BY P.J. Lowe	REFERENCE	

HERCULES MINE  
 LONGITUDINAL PROJECTION

DRAWING NO.:  
 DEPARTMENT OF MINES  
 76025

0055\_435