




G Lode

MICROFILMED

BROUGHT TO DATE : 31.12.75
 MINE MANAGER : *[Signature]*
 MINE SURVEYOR : *[Signature]*



0055_437

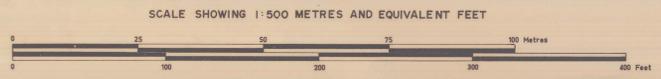

ELECTROLYTIC ZINC COMPANY OF AUSTRALASIA LIMITED
 WEST COAST MINES, T.A.S.

SURVEY BY		SCALE	1 : 500 METRES
DRAWN BY		DATE	1973
TRACED BY	P. J. Lowe	REFERENCE	

HERCULES MINE
 N° 6 LEVEL

DRAWING N° :
 DEPARTMENT OF MINES
 PLAN 76023

0055_437