




0055_438

MICRO-LIMITED

BROUGHT TO DATE - 31.12.75
 MINE MANAGER *[Signature]*
 MINE SURVEYOR *[Signature]*

0055_438

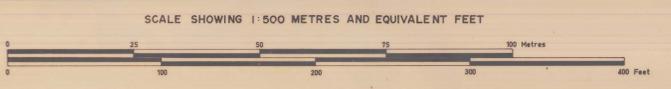

ELECTROLYTIC ZINC COMPANY OF AUSTRALASIA LIMITED
 WEST COAST MINES, TAS.

SURVEY BY		SCALE	1 : 500 METRES
DRAWN BY		DATE	1973
TRACED BY	P. J. Lowe	REFERENCE	

HERCULES MINE
 No 6 LEVEL

DRAWING No.:
 DEPARTMENT OF MINES
 PLAN 76022