




0055_441

MICROFILMED

BROUGHT TO DATE : 31.12.75
 MINE MANAGER : *[Signature]*
 MINE SURVEYOR : *[Signature]*

0055_441

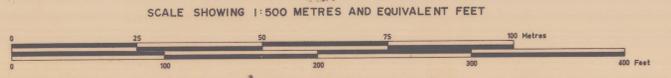

ELECTROLYTIC ZINC COMPANY OF AUSTRALASIA LIMITED
 WEST COAST MINES, T.A.S.

SURVEY BY		SCALE	1 : 500 METRES
DRAWN BY		DATE	1973
TRACED BY	P. J. Lowe	REFERENCE	

HERCULES MINE
 No. 5 LEVEL
 100m.S - 500m.N

DRAWING No. :
 DEPARTMENT OF MINES
 PLAN 76019