


0055_442



SCALE SHOWING 1:500 METRES AND EQUIVALENT FEET

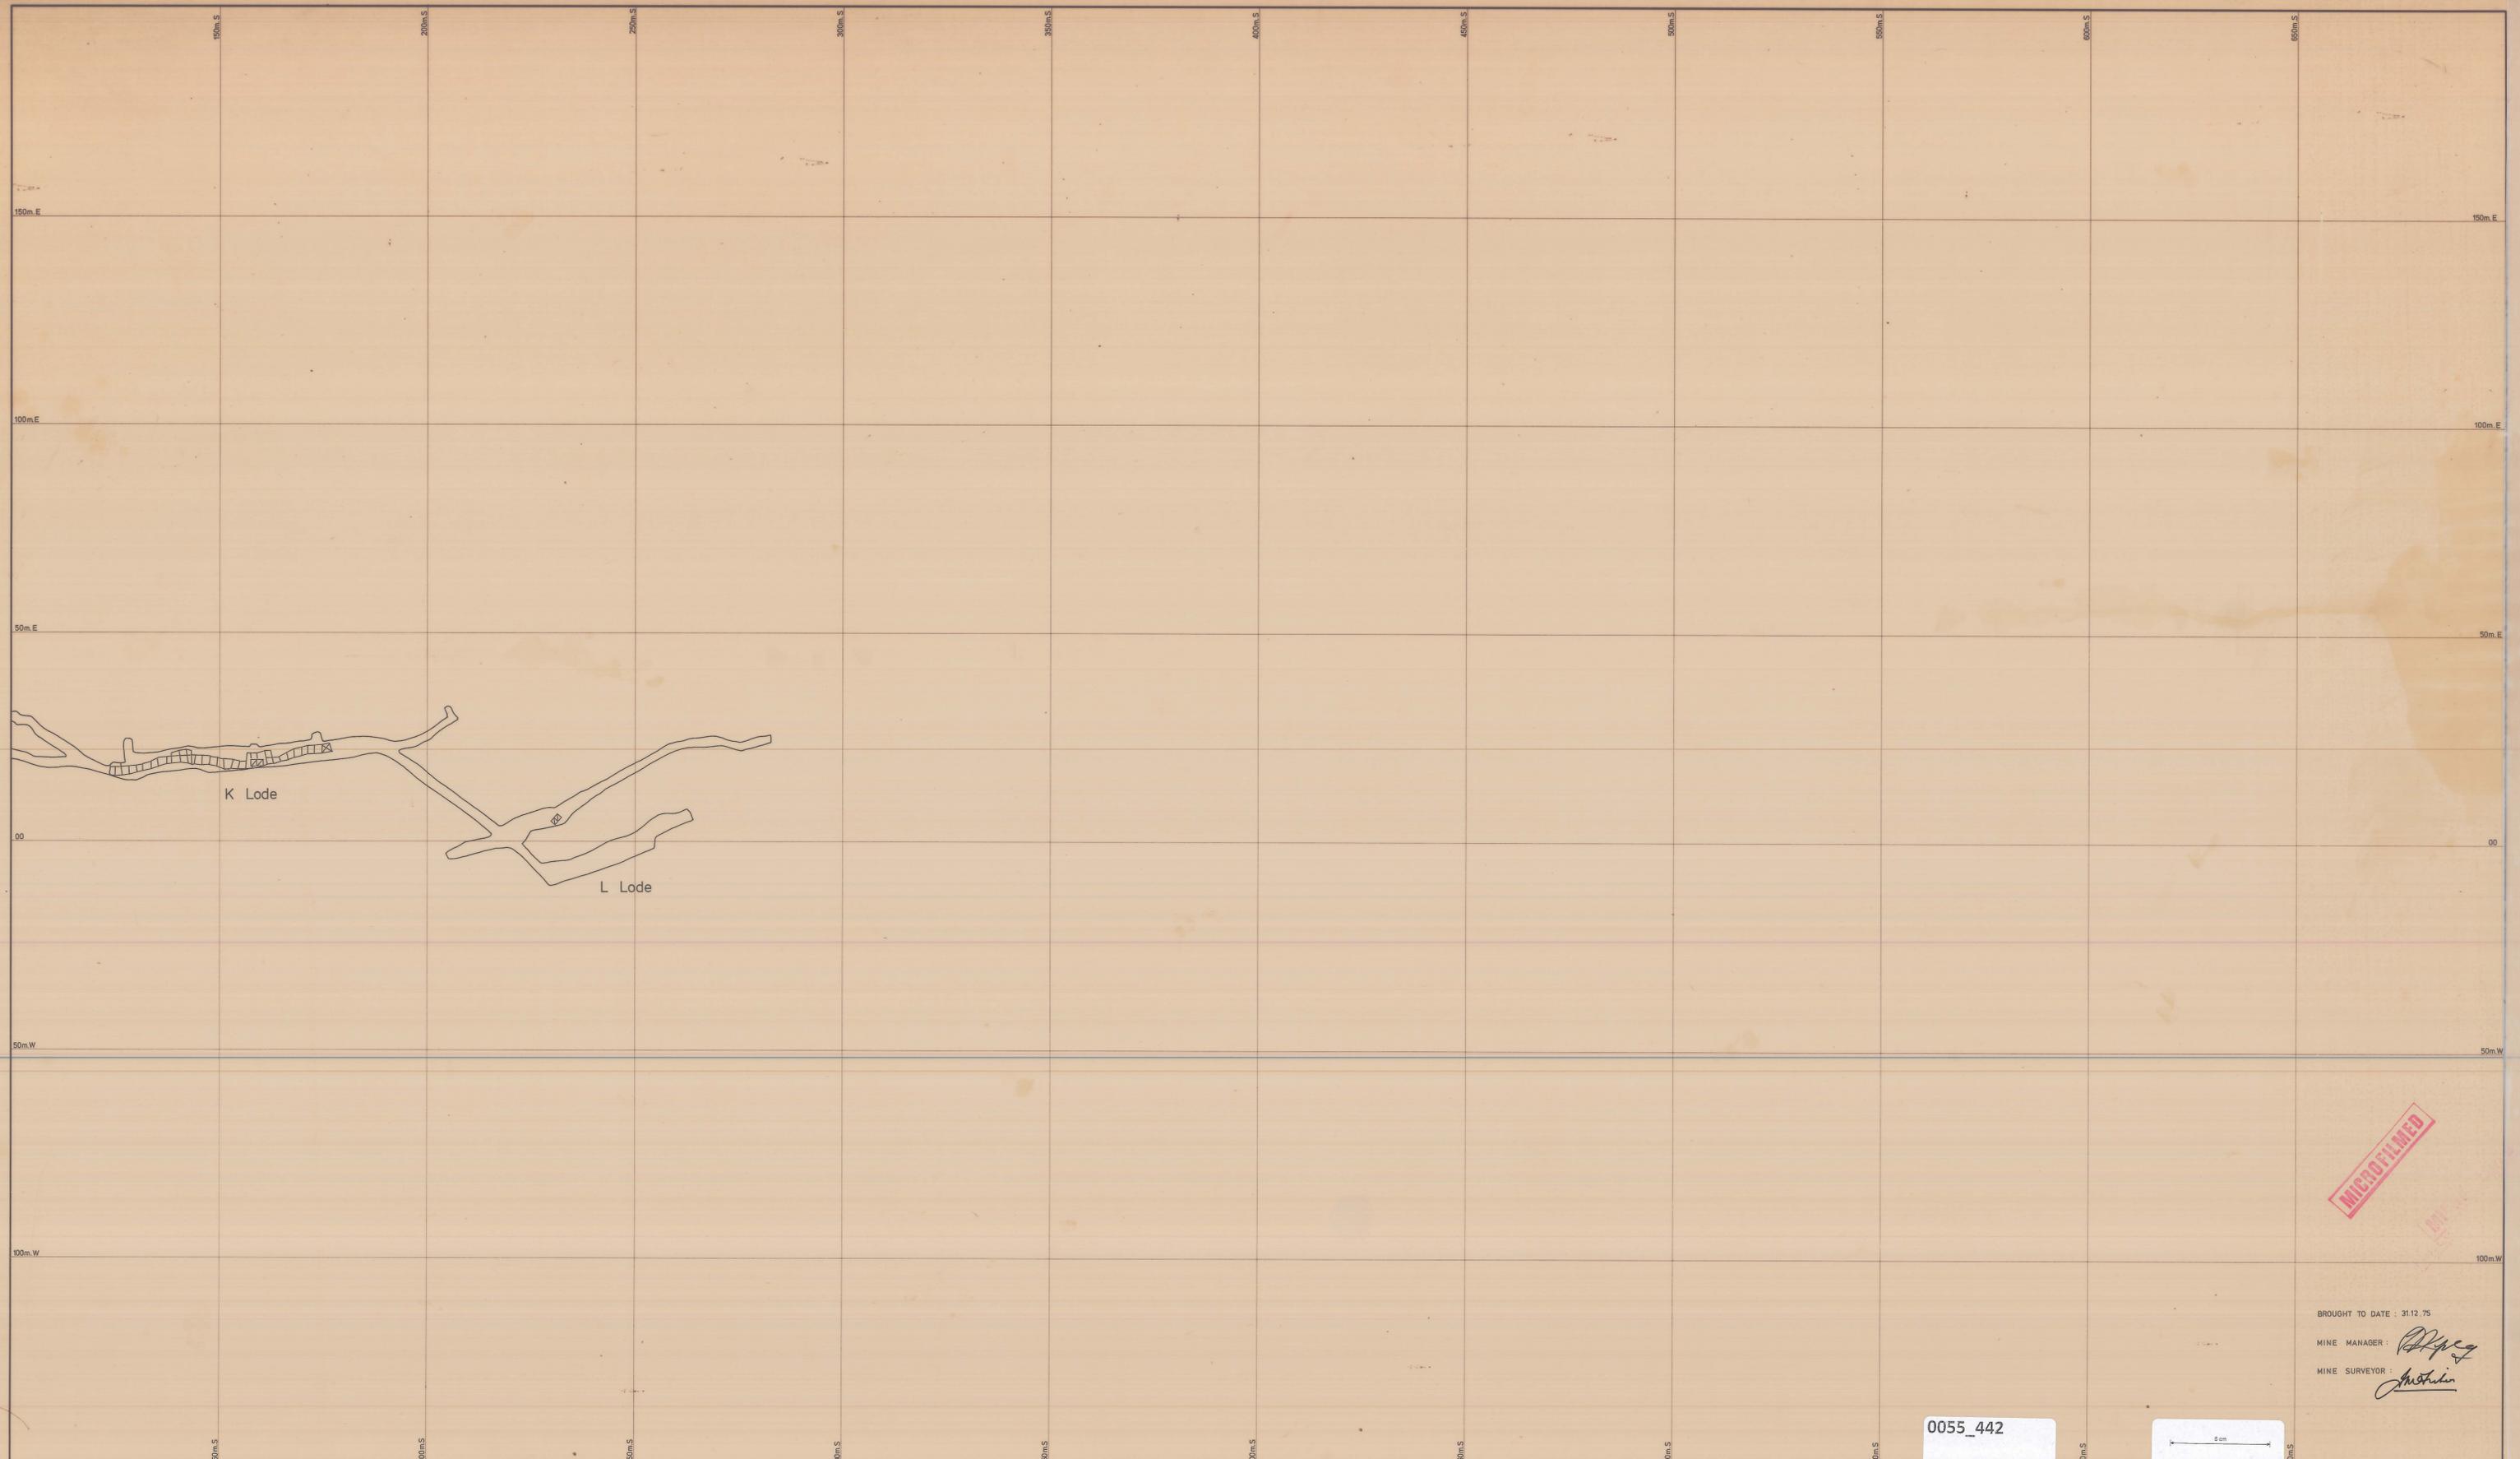

ELECTROLYTIC ZINC COMPANY OF AUSTRALASIA LIMITED
WEST COAST MINES, T.A.S.

SURVEY BY		SCALE	1 : 500 METRES
DRAWN BY		DATE	1973
TRACED BY	P. J. Lowe	REFERENCE	

0055_442



HERCULES MINE
Nº 5 LEVEL
100m.S - 700m.S

DRAWING Nº:
DEPARTMENT OF MINES
PLAN

76018

BROUGHT TO DATE : 31.12.75
MINE MANAGER : *[Signature]*
MINE SURVEYOR : *[Signature]*

MICROFILMED