


MICROFILMED

BROUGHT TO DATE : 31.12.75  
 MINE MANAGER : *[Signature]*  
 MINE SURVEYOR : *[Signature]*

0055\_443

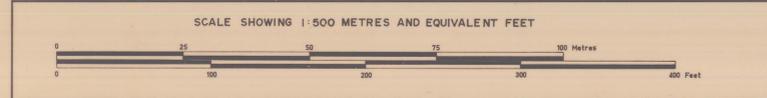

**ELECTROLYTIC ZINC COMPANY OF AUSTRALASIA LIMITED**  
 WEST COAST MINES, T.A.S.

SURVEY BY	SCALE	1 : 500 METRES
DRAWN BY	DATE	1973
TRACED BY P. J. Lowe	REFERENCE	

HERCULES MINE  
 No 4 LEVEL  
 00-600m.N

DRAWING No :  
 DEPARTMENT OF MINES  
 PLAN 76017

0055\_443