


0055\_445



MICROFILMED

BROUGHT TO DATE : 31.12.75  
 MINE MANAGER : *[Signature]*  
 MINE SURVEYOR : *[Signature]*

0055\_445

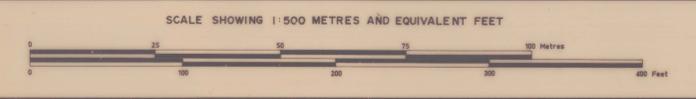

ELECTROLYTIC ZINC COMPANY OF AUSTRALASIA LIMITED  
 WEST COAST MINES, T.A.S.

|           |           |           |                |
|-----------|-----------|-----------|----------------|
| SURVEY BY |           | SCALE     | 1 : 500 METRES |
| DRAWN BY  |           | DATE      | 1973           |
| TRACED BY | P.J. Lowe | REFERENCE |                |

HERCULES MINE  
 No. 3 LEVEL

DRAWING N°:  
 DEPARTMENT OF MINES  
 PLAN 76015