


0055_447

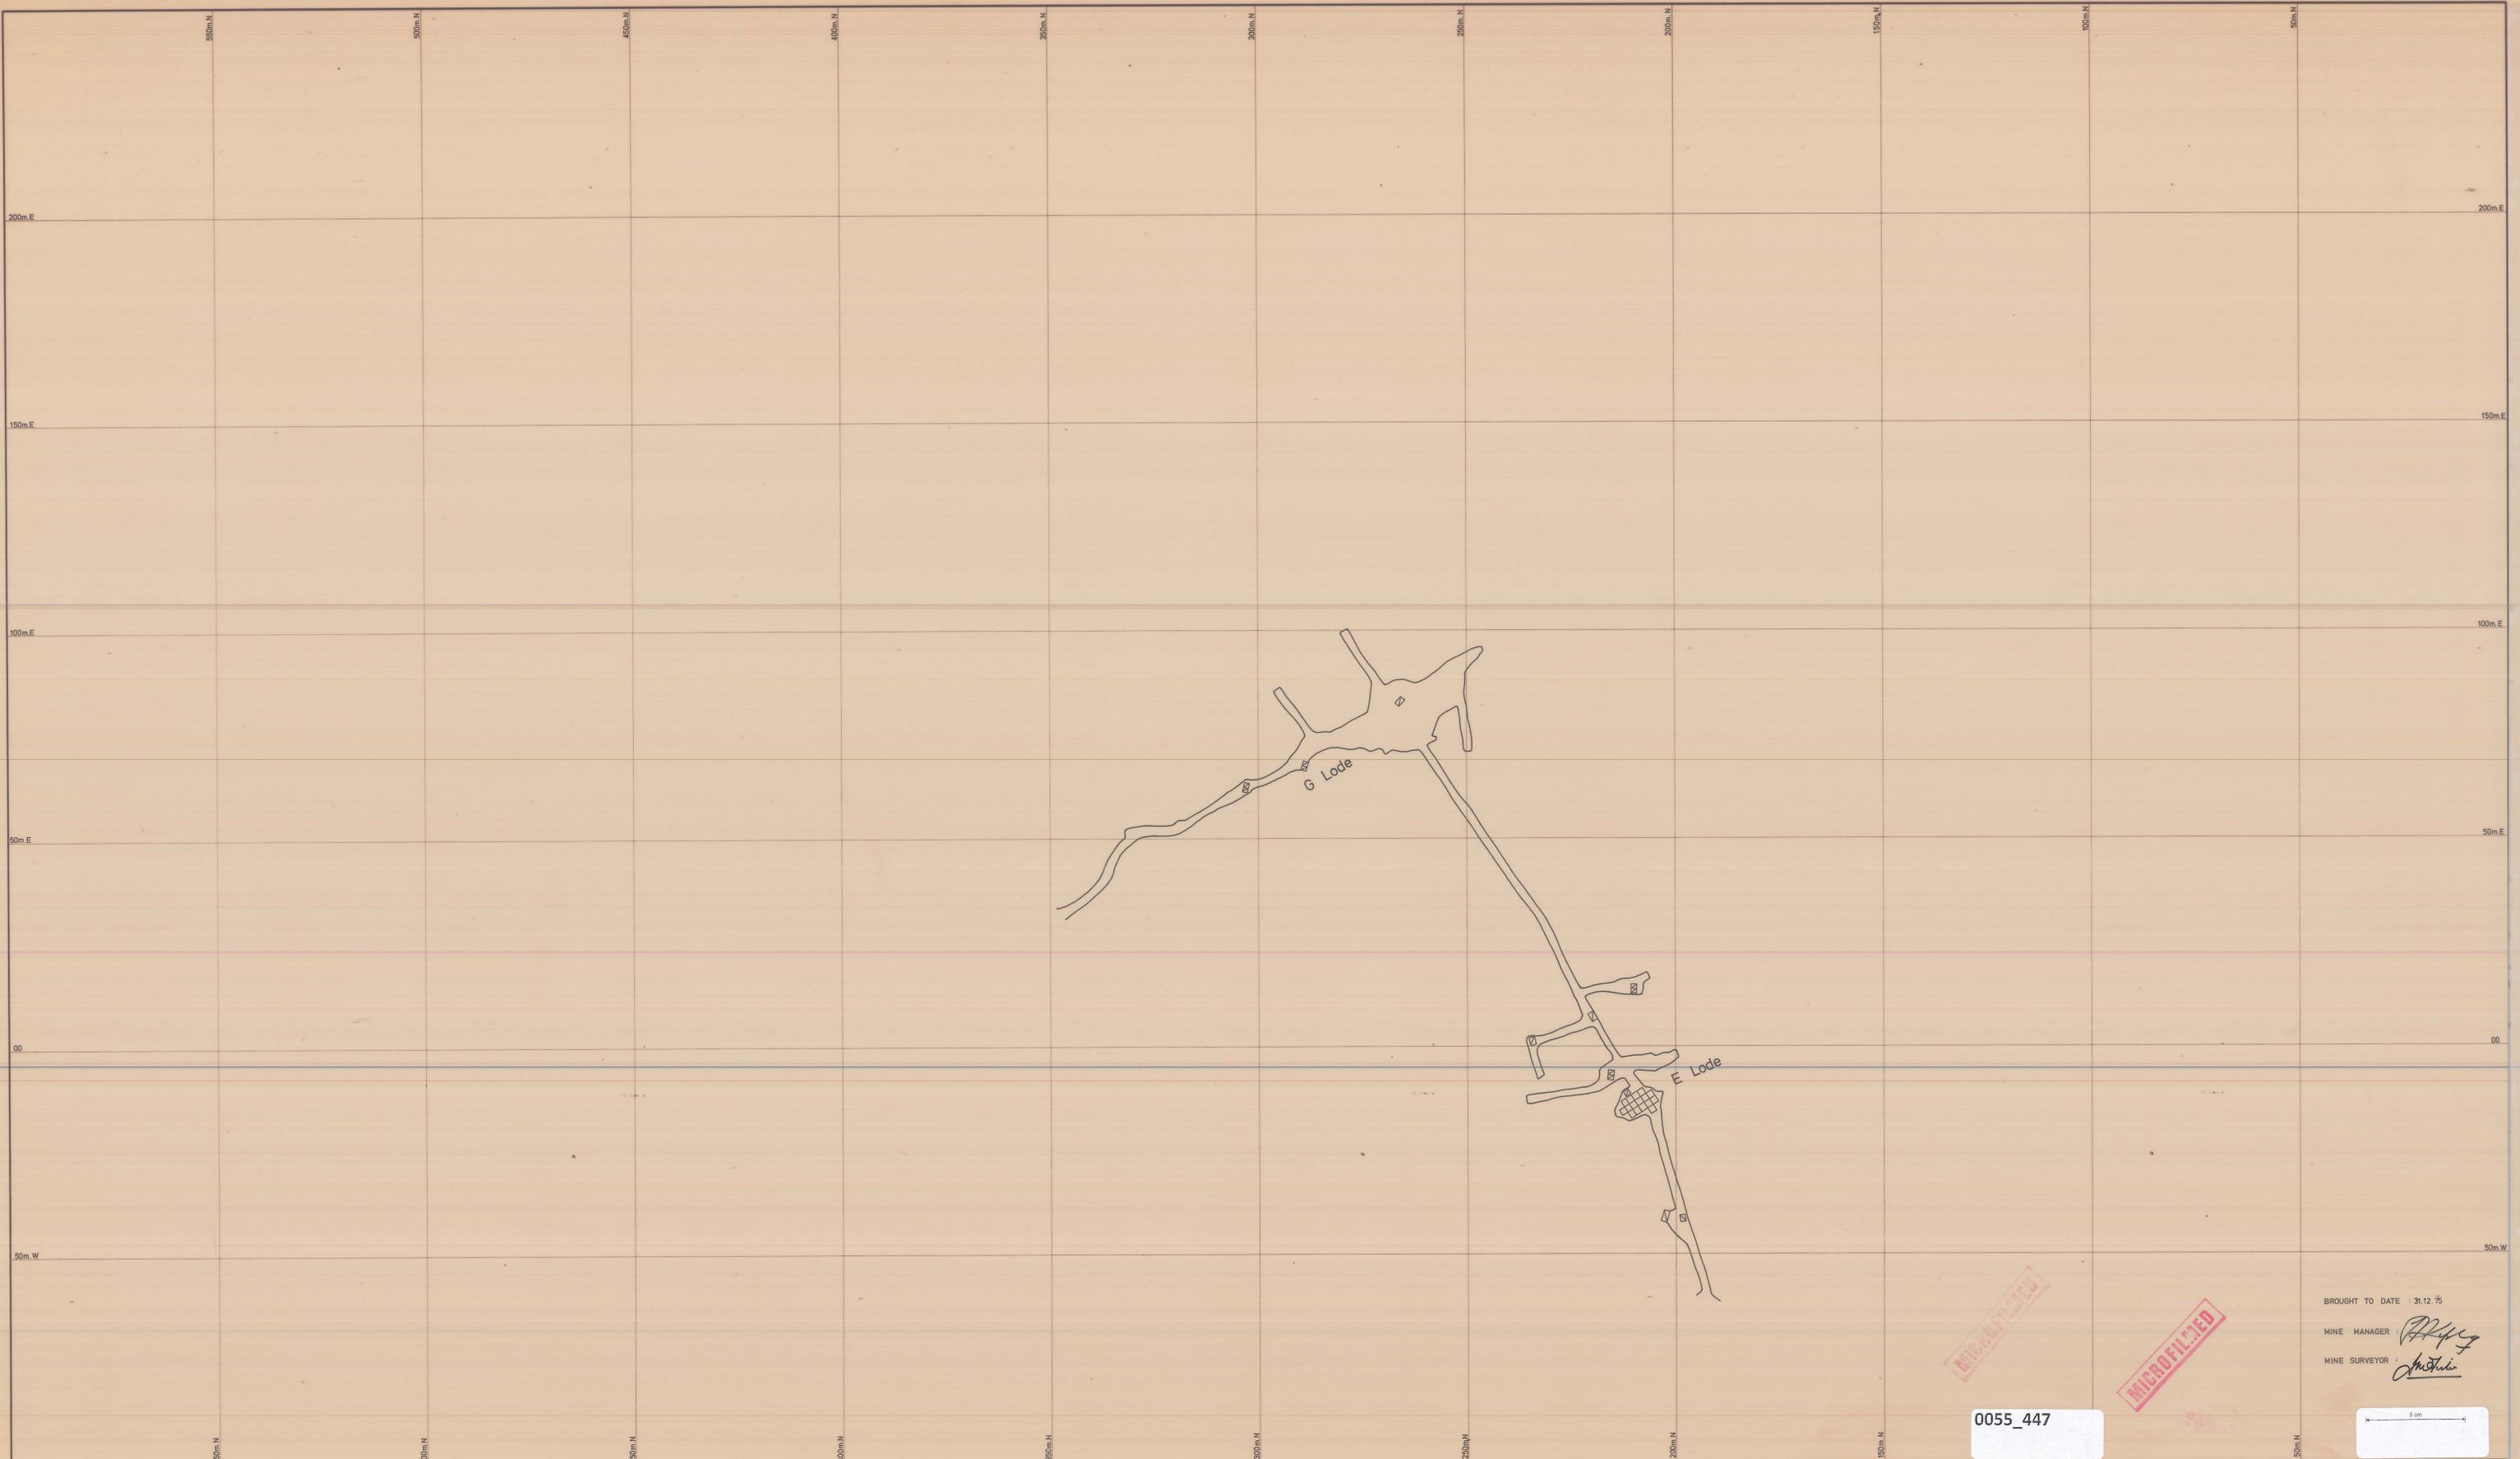


MICROFILMED

MICROFILMED

0055_447

BROUGHT TO DATE : 31.12.75
 MINE MANAGER : *[Signature]*
 MINE SURVEYOR : *[Signature]*

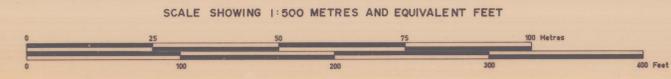

ELECTROLYTIC ZINC COMPANY OF AUSTRALASIA LIMITED
 WEST COAST MINES, T.A.S.

SURVEY BY		SCALE	1 : 500 METRES.
DRAWN BY		DATE	1973
TRACED BY	P. J. Lowe	REFERENCE	

HERCULES MINE
 N° 3A LEVEL
 00 - 600m.N

DRAWING N° :
 DEPARTMENT OF MINES
 PLAN 76013