


0055_448

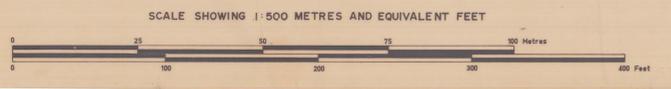

ELECTROLYTIC ZINC COMPANY OF AUSTRALASIA LIMITED
WEST COAST MINES, T.A.S.

SURVEY BY		SCALE	1 : 500
DRAWN BY		DATE	1973
TRACED BY	P. J. Lowe	REFERENCE	

0055_448

HERCULES MINE
LEVEL PLAN

MICROFILMED

BROUGHT TO DATE : 31.12.75
MINE MANAGER : *[Signature]*
MINE SURVEYOR : *[Signature]*



DRAWING N° :
DEPARTMENT OF MINES
7602