



0055\_450

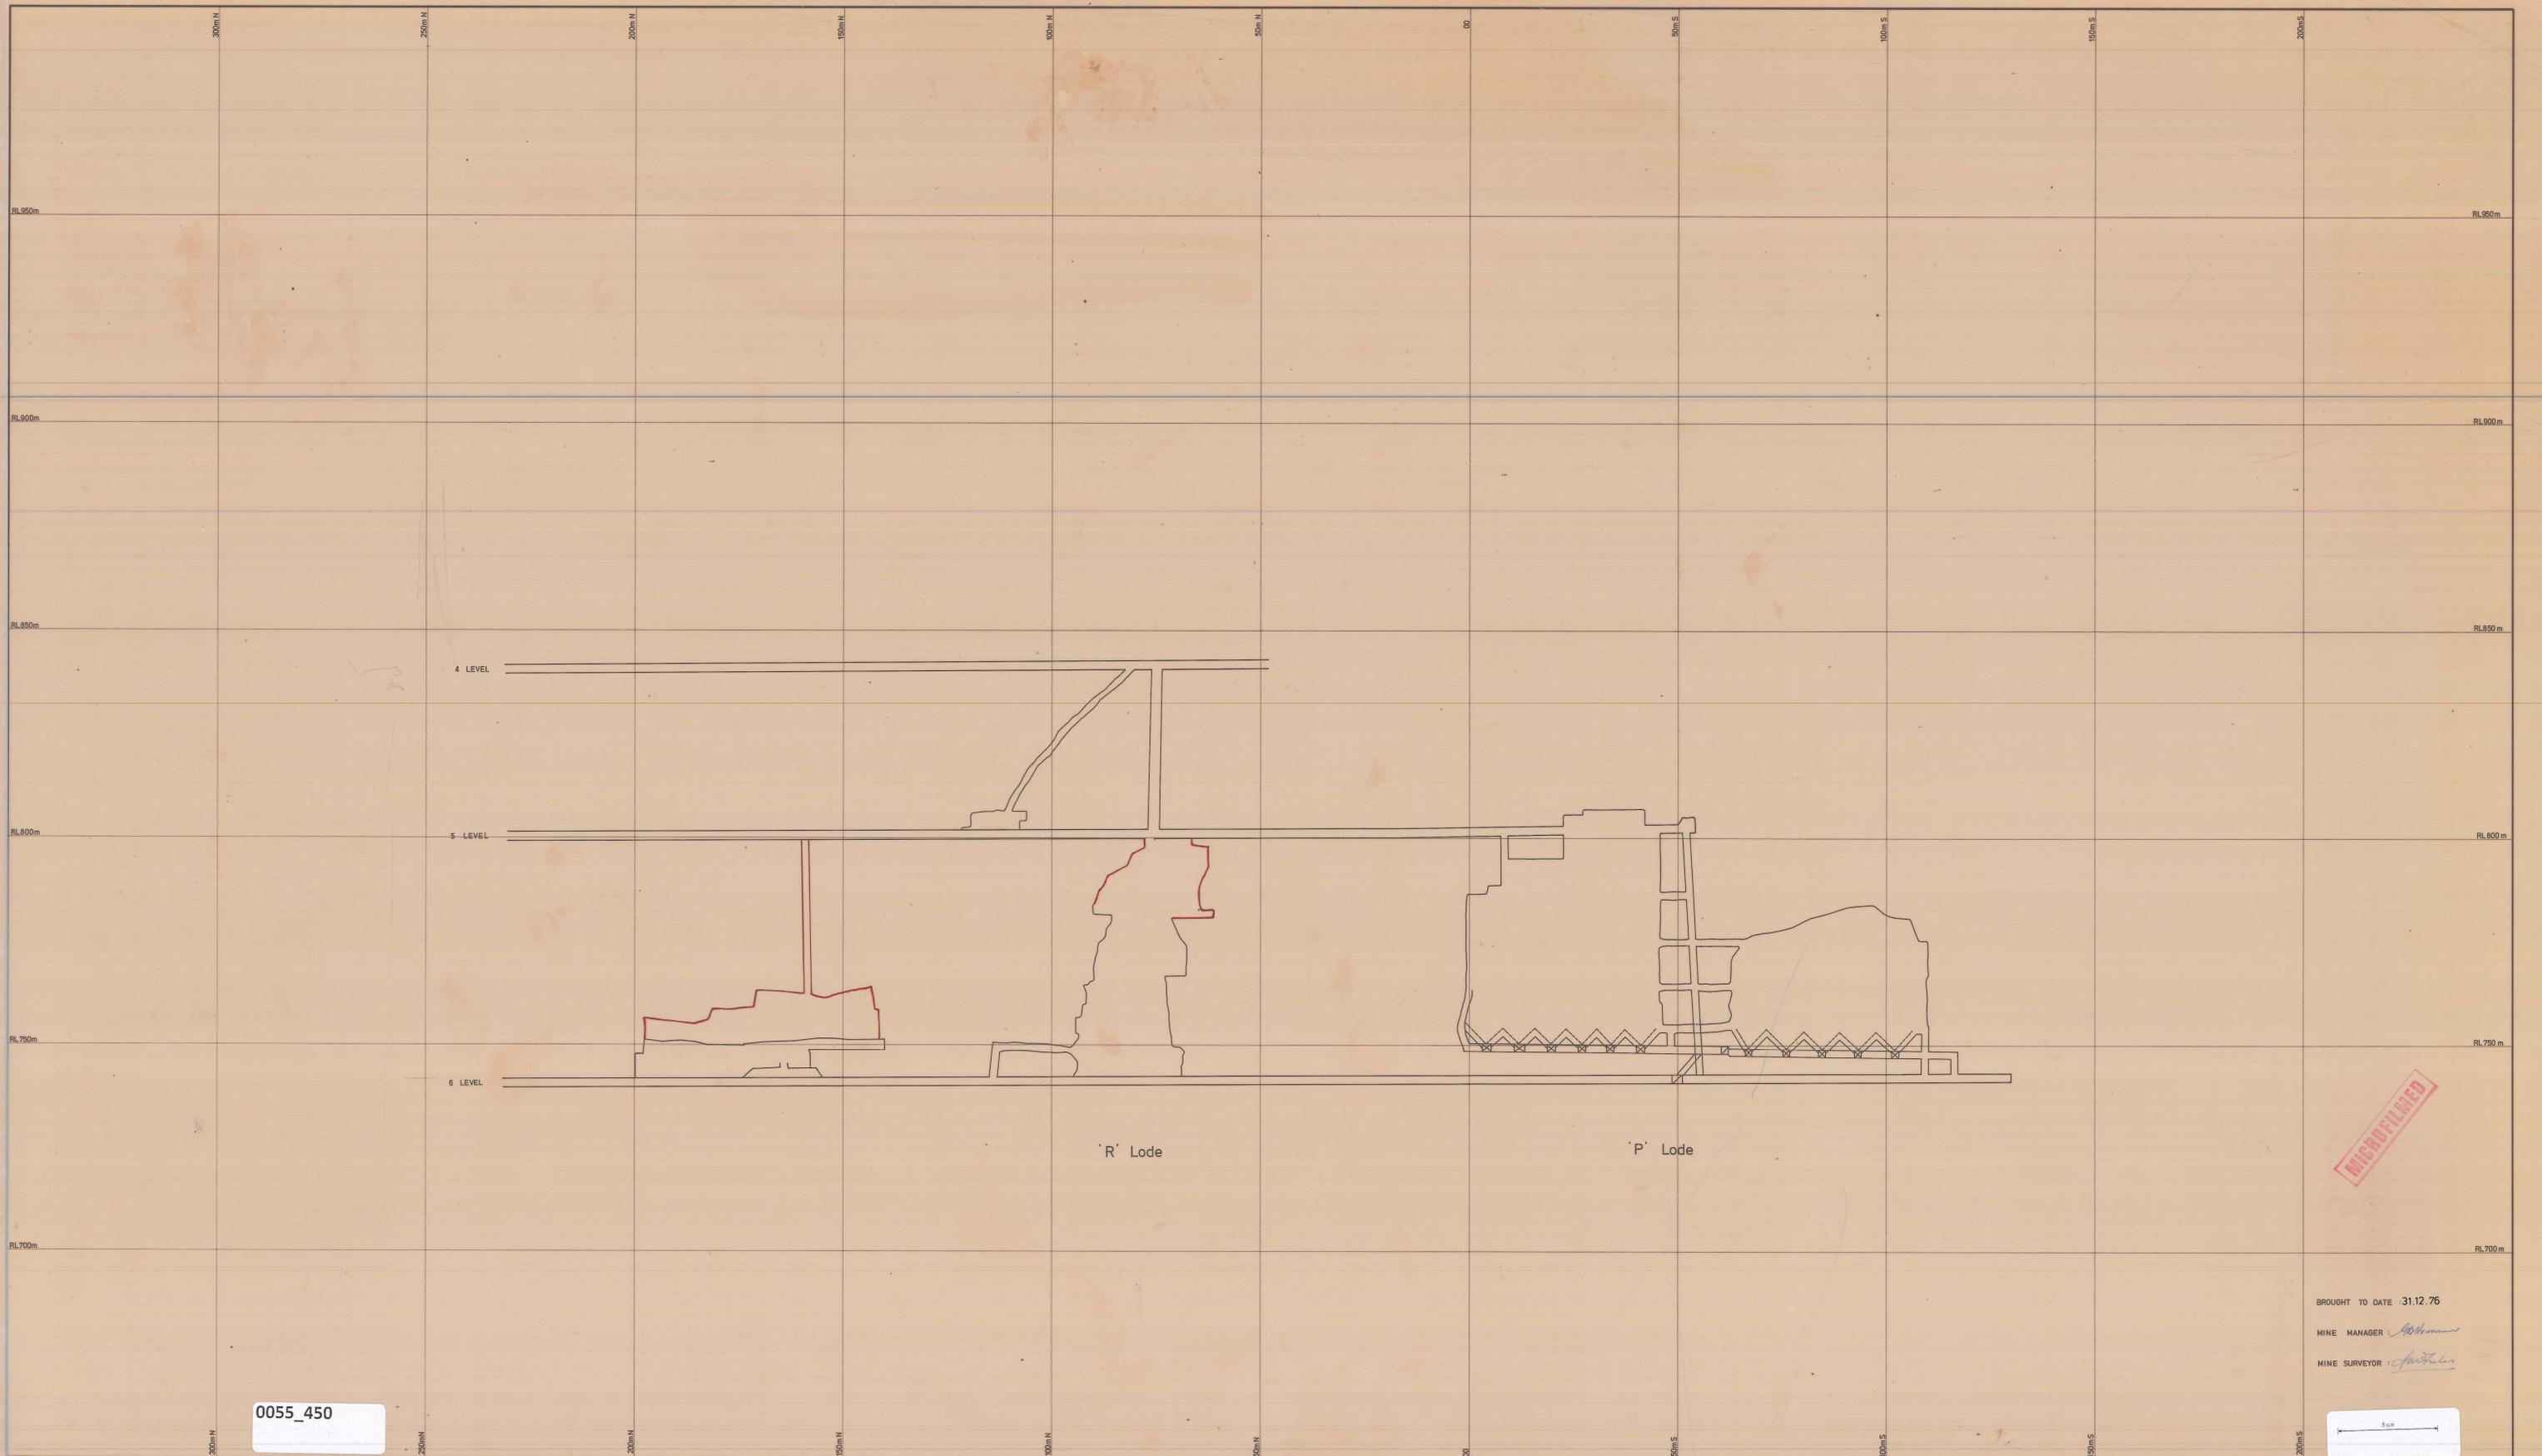

0055\_450

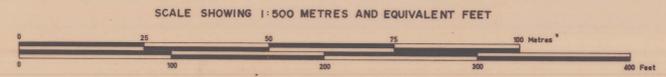


ELECTROLYTIC ZINC COMPANY OF AUSTRALASIA LIMITED  
 WEST COAST MINES, T.A.S.

SURVEY BY		SCALE	1 : 500
DRAWN BY		DATE	1973
TRACED BY	P.J. Lowe	REFERENCE	

HERCULES MINE  
 LONGITUDINAL PROJECTION

BROUGHT TO DATE 31.12.76  
 MINE MANAGER *[Signature]*  
 MINE SURVEYOR *[Signature]*

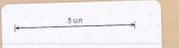

DRAWING N°:  
 DEPARTMENT OF MINES

71001