
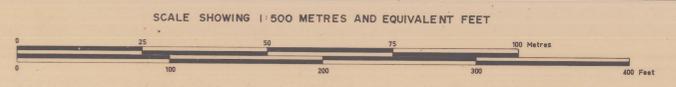


0055\_453

**MICROFILMED**  
**MICROFILMED**

BROUGHT TO DATE 31.12.76  
MINE MANAGER *A. Williams*  
MINE SURVEYOR *J. J. Lowe*

0055\_453

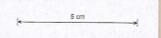

**ELECTROLYTIC ZINC COMPANY OF AUSTRALASIA LIMITED**  
WEST COAST MINES, T.A.S.

SURVEY BY		SCALE	1 : 500
DRAWN BY		DATE	1973
TRACED BY	P. J. Lowe	REFERENCE	

ROSEBERY MINE  
LONGITUDINAL PROJECTION  
SPECIFIC STOPES.

DRAWING N°:  
DEPARTMENT OF MINES  
77026