

0055_454

3000m
2950 m
2900m
2850m
2800m

100mN

50mN

00

50mS

100mS


150mS

200mS

250mS

300mS


350mS

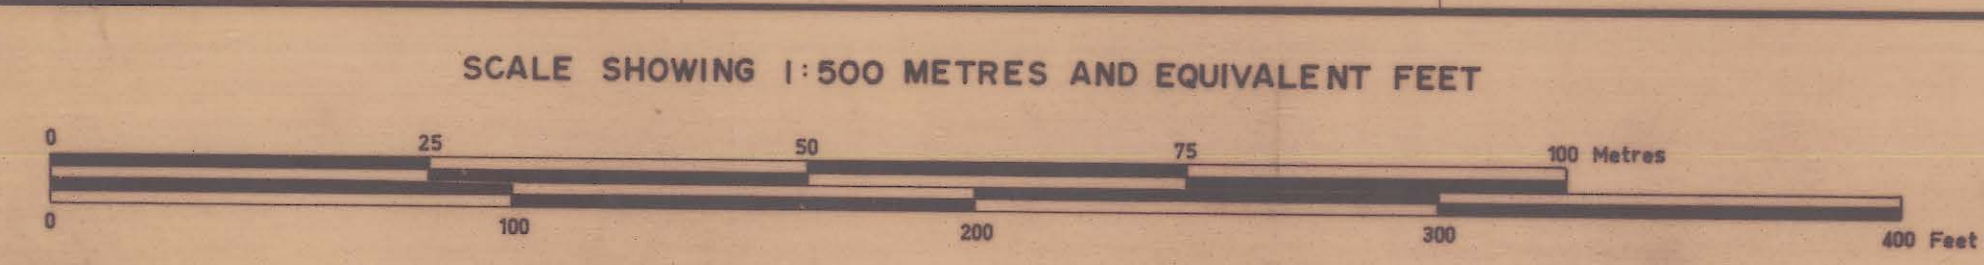

ELECTROLYTIC ZINC COMPANY OF AUSTRALASIA LIMITED
WEST COAST MINES, TAS.

SURVEY BY		SCALE	1:500 METRES
DRAWN BY		DATE	1976
TRACED BY		REFERENCE	

0055_454

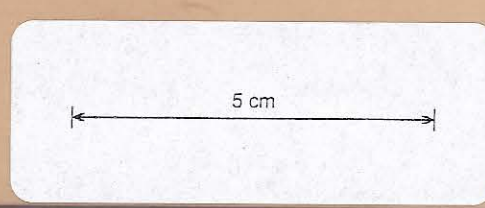

ROSEBERY MINE
LONGITUDINAL PROJECTION
'F' LENS

BROUGHT TO DATE, 31-12-76
MINE MANAGER, *W. H. Hume*
MINE SURVEYOR, *J. M. Fisher*

DRAWING N°:

77025

MICROFILMED