
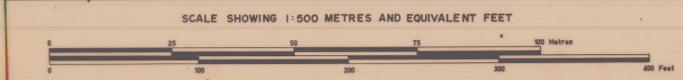


0055_455

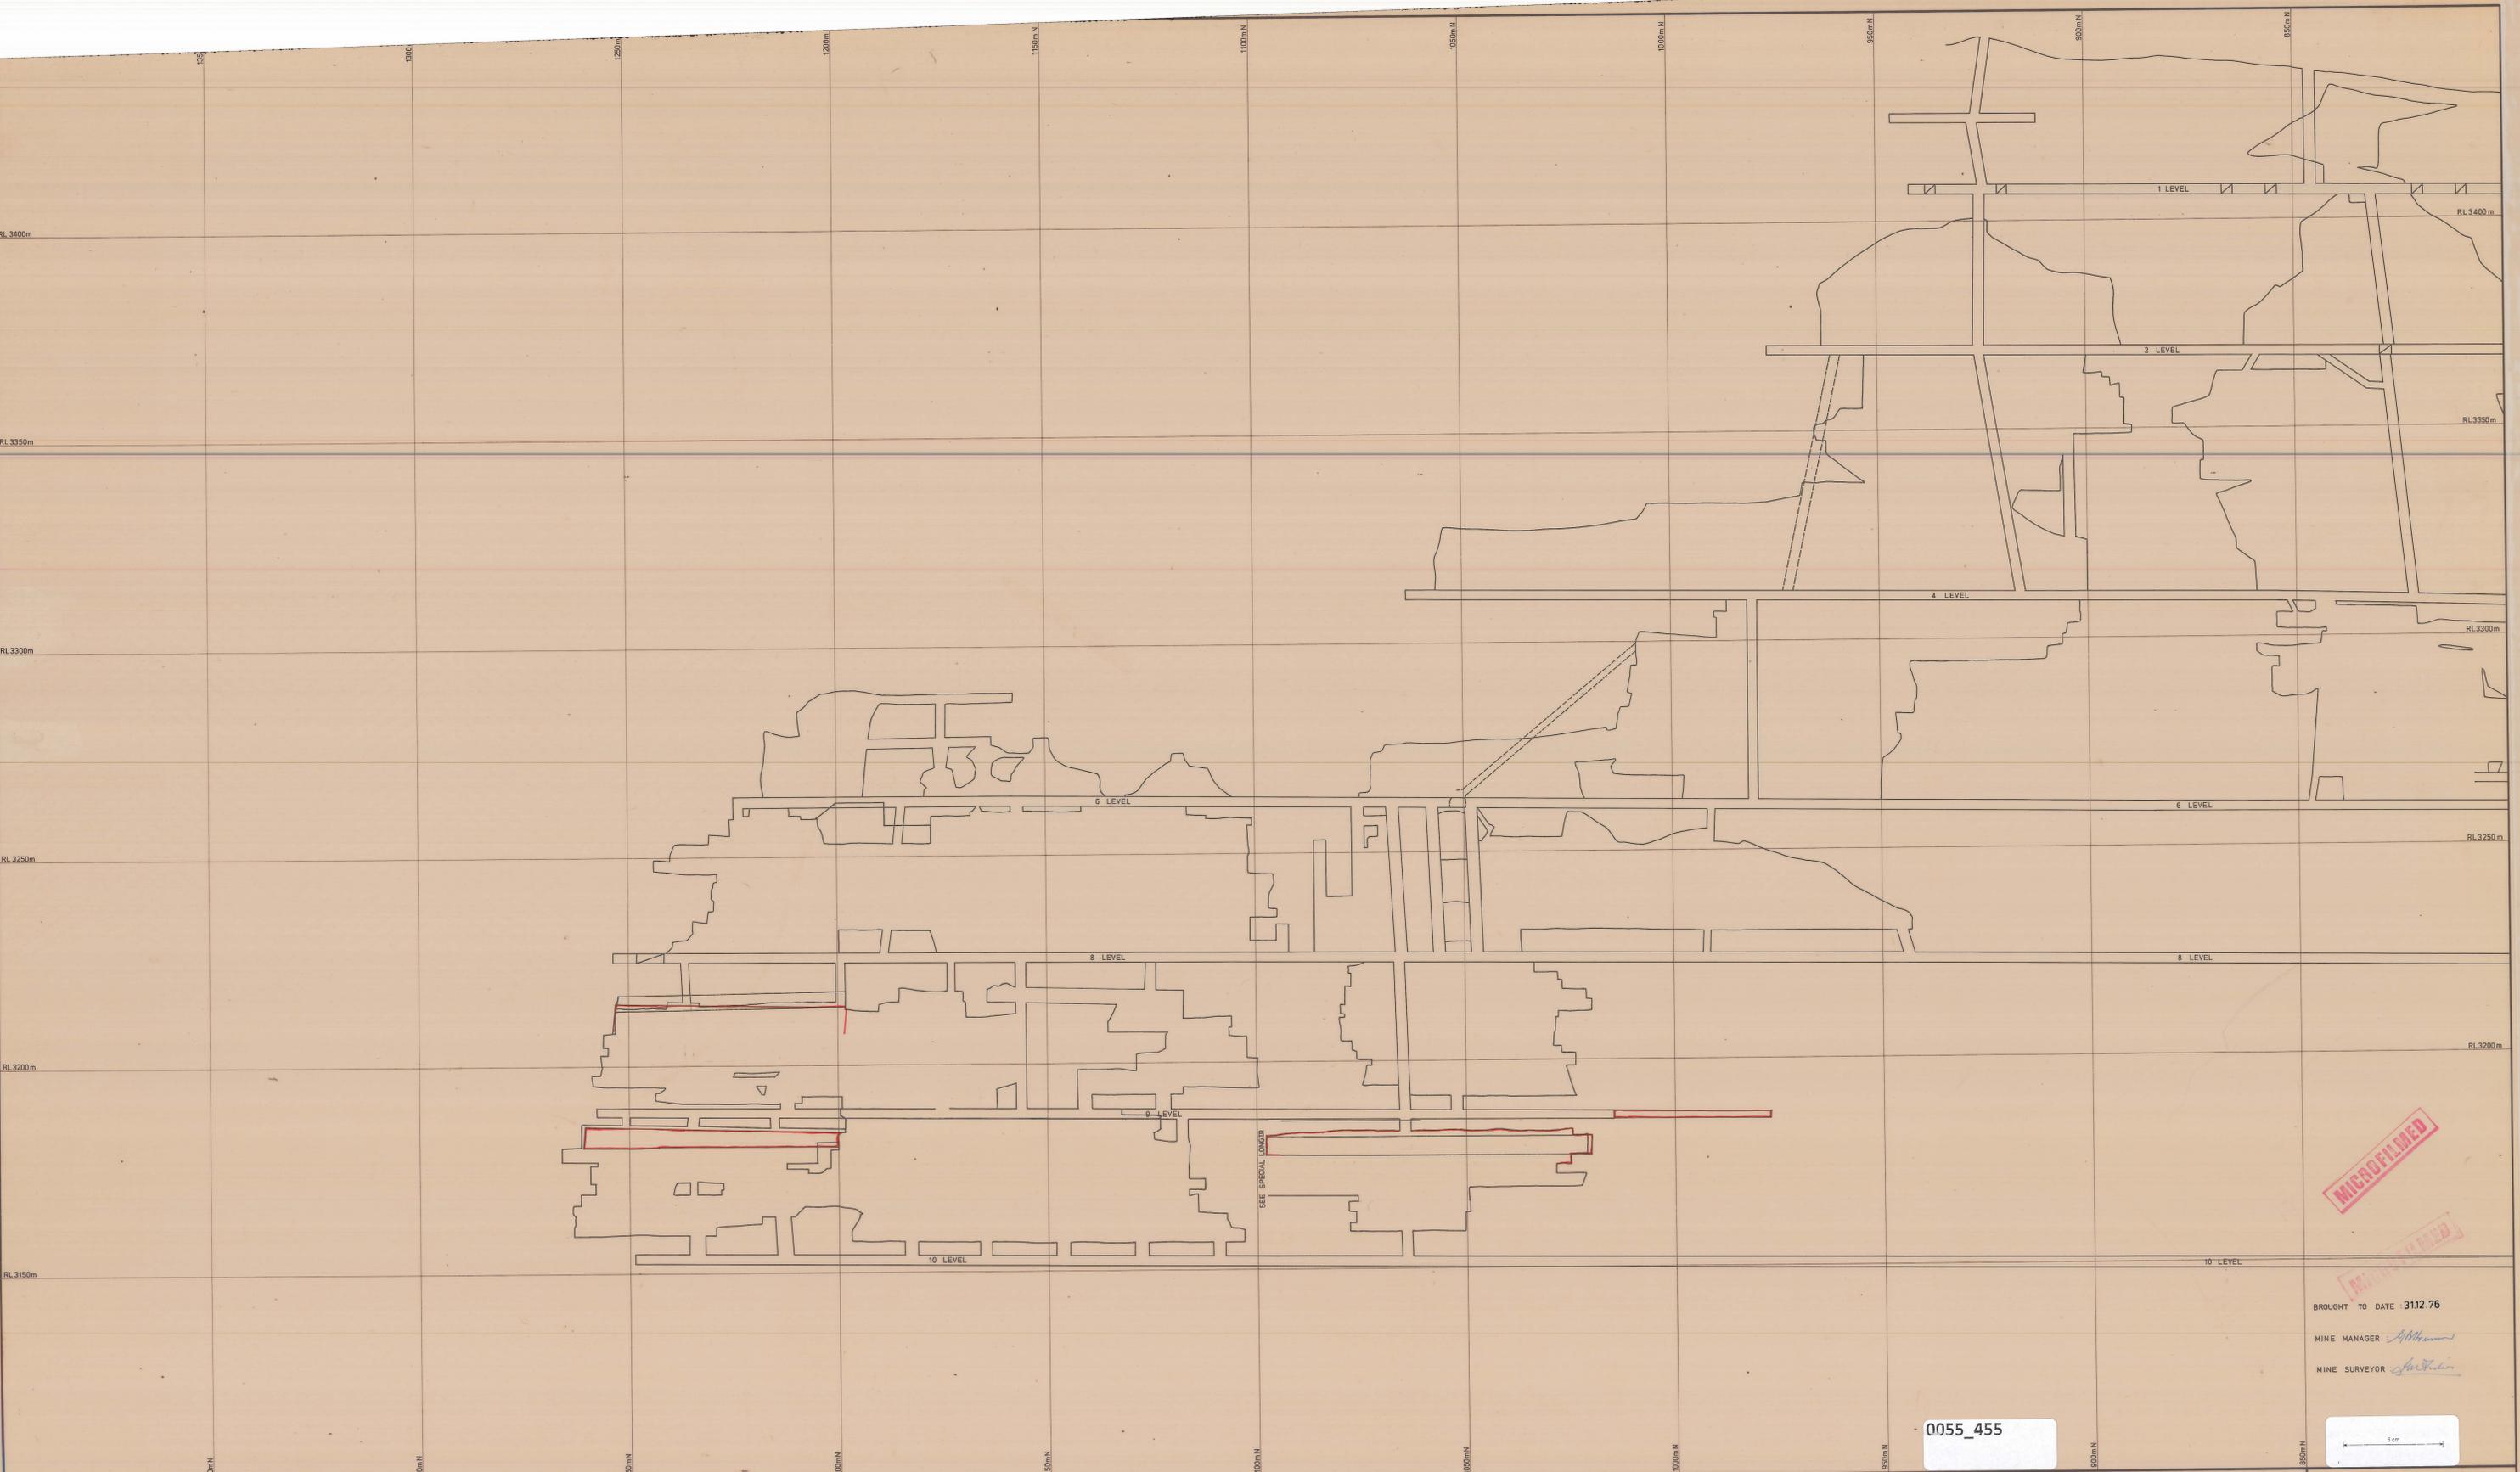

ELECTROLYTIC ZINC COMPANY OF AUSTRALASIA LIMITED
 WEST COAST MINES, T.A.S.

SURVEY BY		SCALE	1 : 500
DRAWN BY		DATE	1973
TRACED BY	P.J. Lowe	REFERENCE	

0055_455

ROSEBERY MINE
 LONGITUDINAL PROJECTION
 NORTH END — ABOVE 10/L.

MICROFILMED

BROUGHT TO DATE - 3112.76
 MINE MANAGER *A. Williams*
 MINE SURVEYOR *A. Williams*

DRAWING NO: 77024

DEPARTMENT OF MINES