


MICROFILMED

BROUGHT TO DATE 31.12.76
 MINE MANAGER: *Abbott*
 MINE SURVEYOR: *Smith*

0055_456

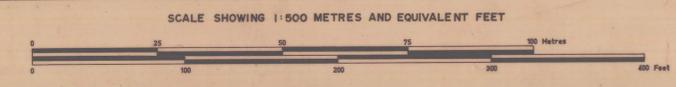

ELECTROLYTIC ZINC COMPANY OF AUSTRALASIA LIMITED
 WEST COAST MINES, T.A.S.

| | | |
|---------------------|-----------|---------|
| SURVEY BY | SCALE | 1 : 500 |
| DRAWN BY | DATE | 1973 |
| TRACED BY P.J. Lowe | REFERENCE | |

ROSEBERY MINE
 LONGITUDINAL PROJECTION
 200mN-800mN — ABOVE 10/L.

DRAWING N^o:
 DEPARTMENT OF MINES
 77023

0055_456