



0055_458

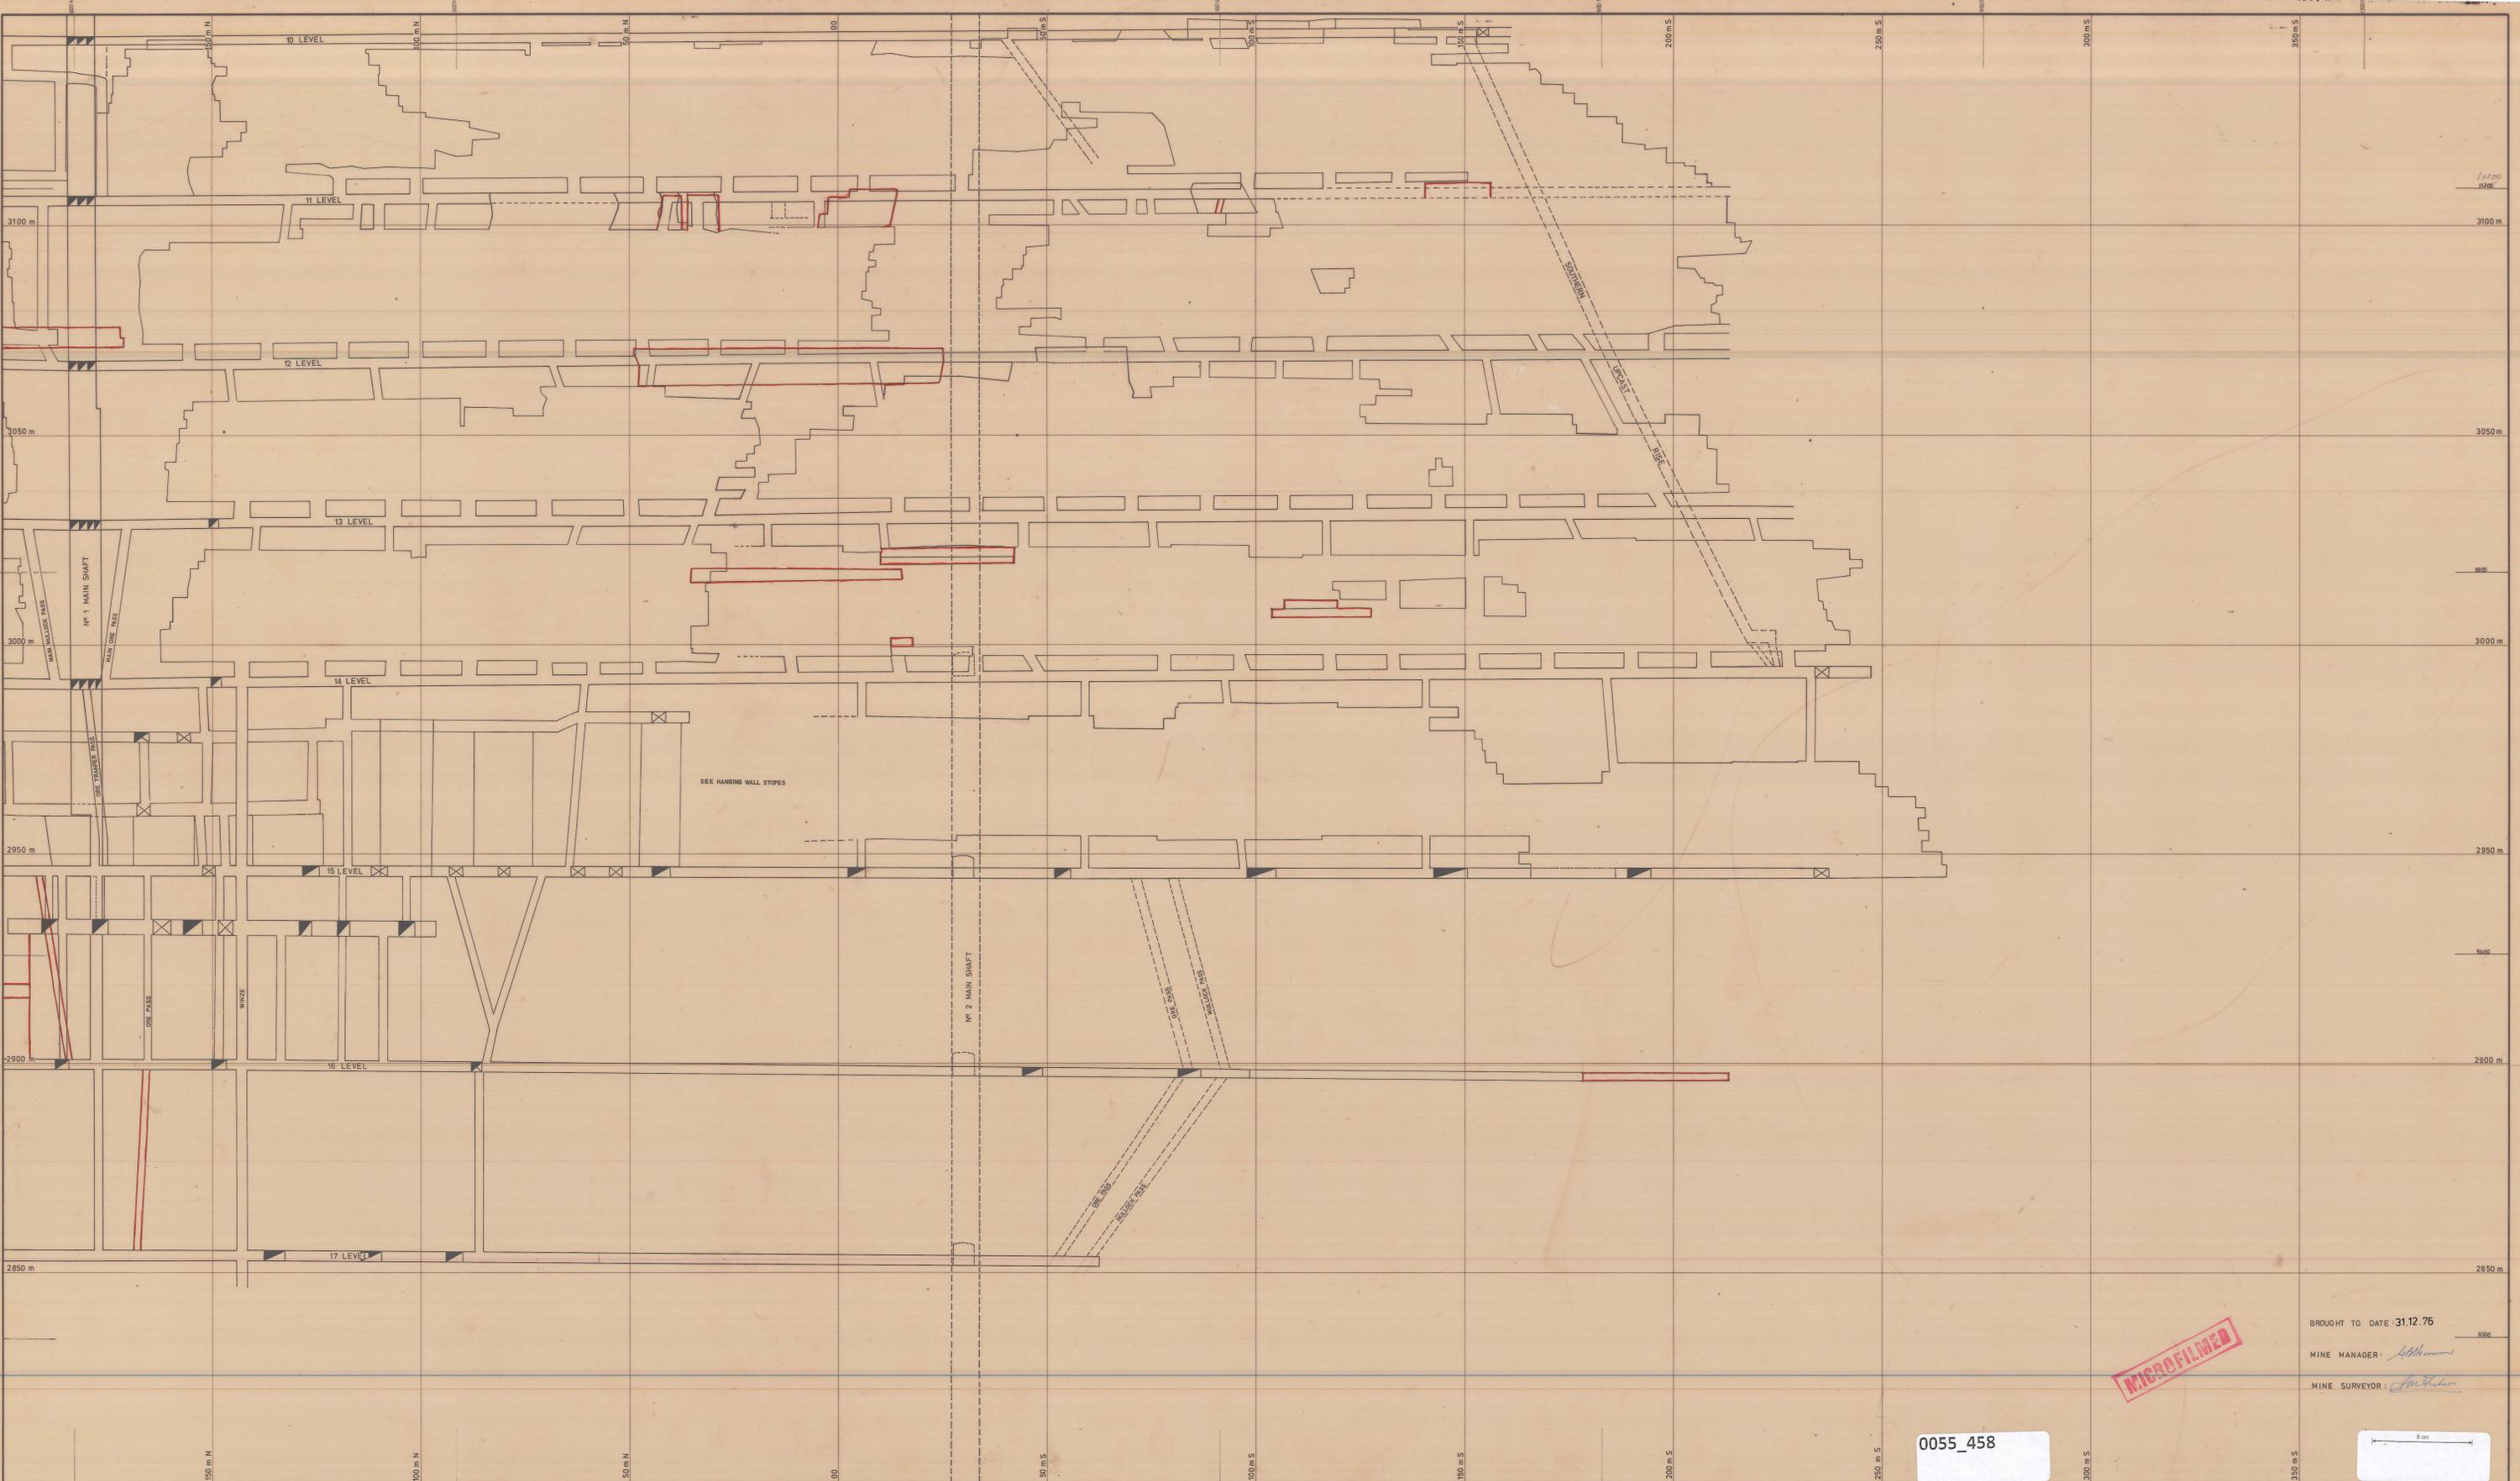

MICROFILMED

BROUGHT TO DATE: 31.12.76
 MINE MANAGER: *W. H. ...*
 MINE SURVEYOR: *J. ...*

0055_458

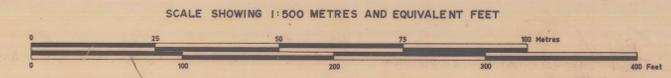

ELECTROLYTIC ZINC COMPANY OF AUSTRALASIA LIMITED
 WEST COAST MINES, T.A.S.

SURVEY BY		SCALE	1:500 metres
DRAWN BY		DATE	1973
TRACED BY	S.M. Burrows	REFERENCE	

ROSEBERY MINE
 LONGITUDINAL PROJECTION
 400m S - 200m N - BELOW 10/L

DRAWING NO.:
 DEPARTMENT OF MINES
 77021