


BROUGHT TO DATE 31.12.76

MINE SURVEYOR

MINE MANAGER



0055\_460

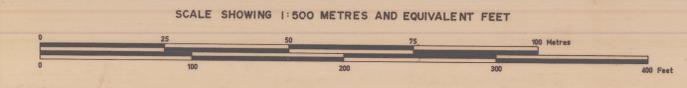

ELECTROLYTIC ZINC COMPANY OF AUSTRALASIA LIMITED  
WEST COAST MINES, T.A.S.

SURVEY BY		SCALE	1 : 500
DRAWN BY		DATE	1973
TRACED BY	P. J. Lowe	REFERENCE	

ROSEBERY MINE  
LONGITUDINAL PROJECTION  
NORTH END - BELOW 10/L.

DRAWING N°:  
DEPARTMENT OF MINES

77019

0055\_460