


0055_463

MICROFILMED

DEPARTMENT OF MINES
 BROUGHT TO DATE 31.12.76
 MINE MANAGER: *A. Whelan*
 MINE SURVEYOR: *A. Whelan*

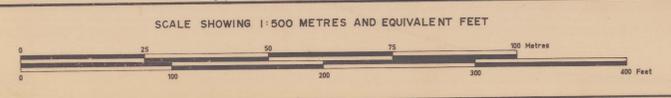

ELECTROLYTIC ZINC COMPANY OF AUSTRALASIA LIMITED
 WEST COAST MINES, T.A.S.

SURVEY BY		SCALE	1:500
DRAWN BY		DATE	1975
TRACED BY	I.T.M.	REFERENCE	

ROSEBERY MINE
 No 16 LEVEL (2) 0055_463

DRAWING No.:
 ① ③
 7796