




0055\_464

**MICROFILMED**

DEPARTMENT OF MINES  
 BROUGHT TO DATE: 31.12.76  
 MINE MANAGER: *[Signature]*  
 MINE SURVEYOR: *[Signature]*

0055\_464

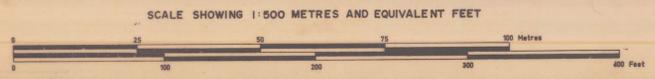

**ELECTROLYTIC ZINC COMPANY OF AUSTRALASIA LIMITED**  
 WEST COAST MINES, T.A.S.

SURVEY BY		SCALE	1:500
DRAWN BY		DATE	1975
TRACED BY	I.T.M.	REFERENCE	

ROSEBERRY MINE  
 No 16 LEVEL ①

DRAWING No: 

①	②	③
---	---	---

 77015