




0055_465

MICROFILMED

DEPARTMENT OF MINES
 BROUGHT TO DATE: 31.12.76
 MINE MANAGER: *[Signature]*
 MINE SURVEYOR: *[Signature]*

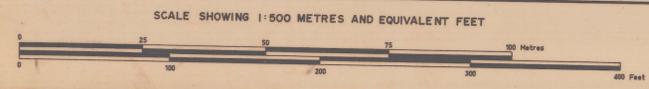

ELECTROLYTIC ZINC COMPANY OF AUSTRALASIA LIMITED
 WEST COAST MINES, T.A.S.

SURVEY BY		SCALE	1:500
DRAWN BY		DATE	1975
TRACED BY	RJR	REFERENCE	

0055_465

ROSEBERY MINE
 No 15 LEVEL (2)

DRAWING No: ① ② ③

77014