


**MICROFILMED**

DEPARTMENT OF MINES  
 BROUGHT TO DATE: 3112.76  
 MINE MANAGER: *[Signature]*  
 MINE SURVEYOR: *[Signature]*

0055\_466

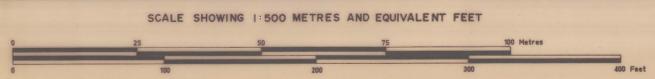

**ELECTROLYTIC ZINC COMPANY OF AUSTRALASIA LIMITED**  
 WEST COAST MINES, T.A.S.

SURVEY BY		SCALE	1:500
DRAWN BY		DATE	1975
TRACED BY	R J R	REFERENCE	

ROSEBERY MINE  
 N° 15 LEVEL ①

DRAWING N°:  
 ① ② ③  
 77013

0055\_466