


0055_470

MICROFILMED

DEPARTMENT OF MINES
 BROUGHT TO DATE 31.12.76
 MINE MANAGER *[Signature]*
 MINE SURVEYOR *[Signature]*

0055_470

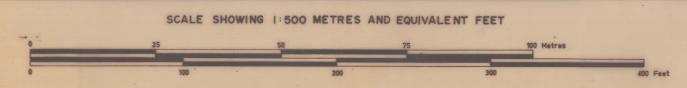

ELECTROLYTIC ZINC COMPANY OF AUSTRALASIA LIMITED
 WEST COAST MINES, TAS.

SURVEY BY		SCALE	1: 500
DRAWN BY		DATE	1975
TRACED BY	I.T.M.	REFERENCE	

ROSEBERY MINE
 N^o 13 LEVEL (1)

DRAWING N^o:
 77009