


0055_474

MICROFILMED

DEPARTMENT OF MINES
 BROUGHT TO DATE 31.12.76
 MINE MANAGER *[Signature]*
 MINE SURVEYOR *[Signature]*

0055_474

8 cm

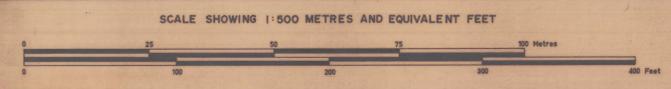

ELECTROLYTIC ZINC COMPANY OF AUSTRALASIA LIMITED
 WEST COAST MINES, T.A.S.

SURVEY BY		SCALE	1:500
DRAWN BY		DATE	1975
TRACED BY	RJR	REFERENCE	

ROSEBERRY MINE
 N° 10 LEVEL ①

DRAWING N°:
 ① ② ③

7605