
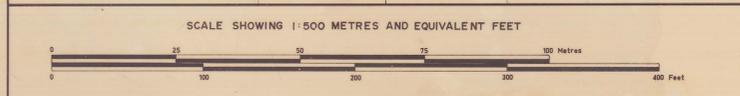
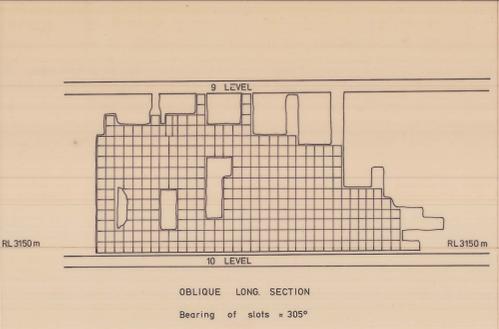
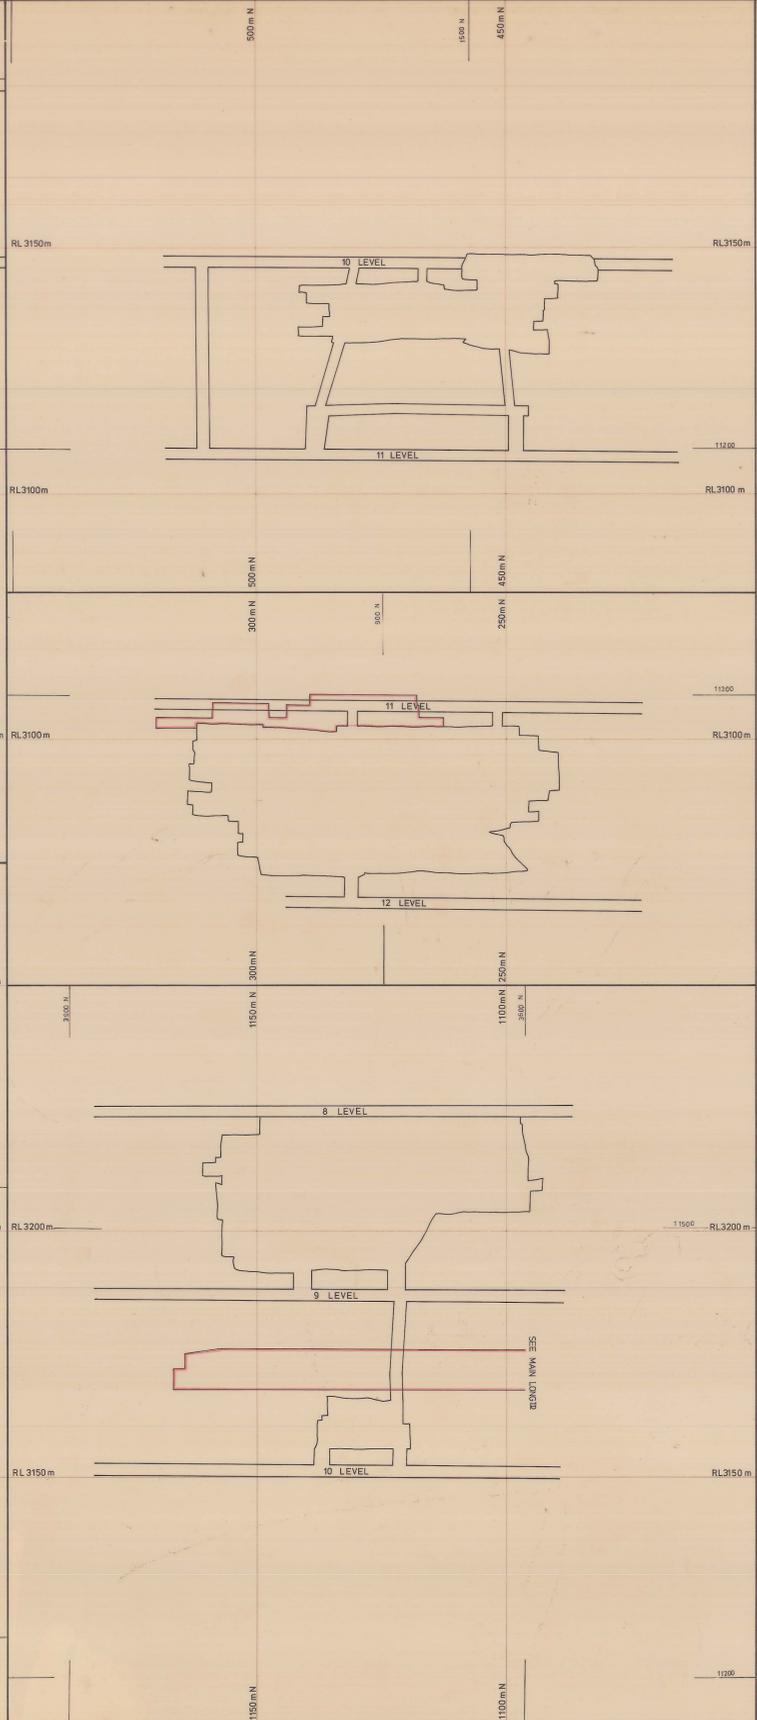


0055_475

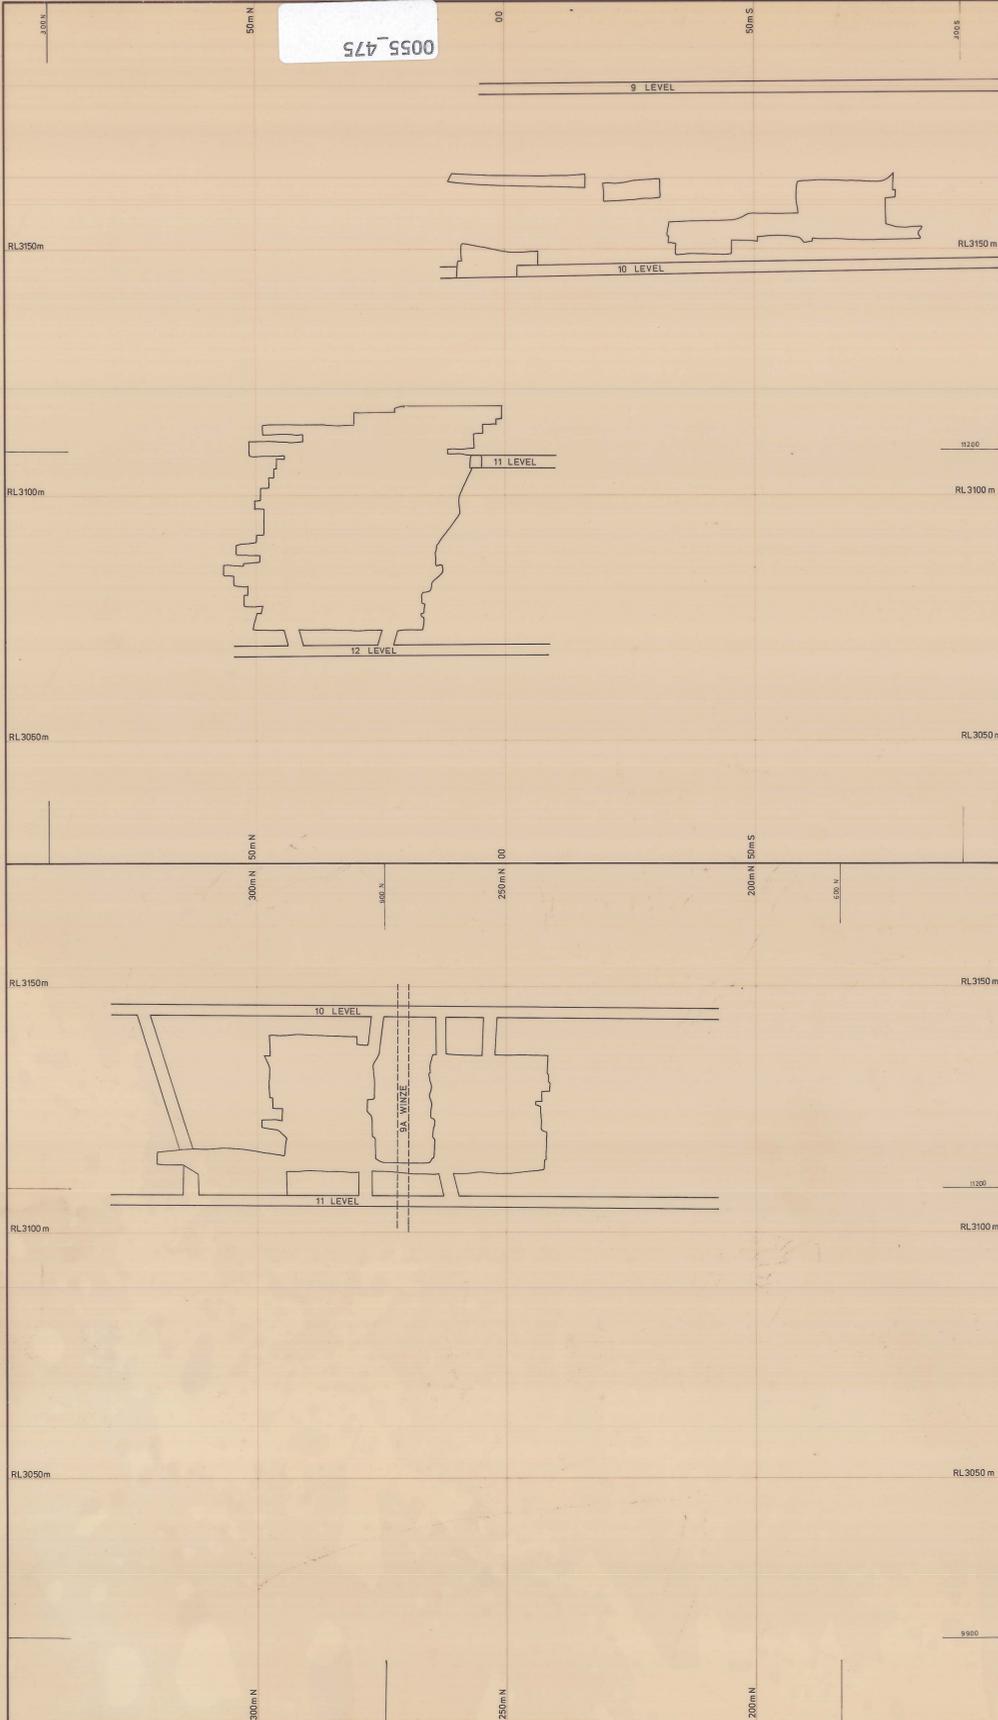

ELECTROLYTIC ZINC COMPANY OF AUSTRALASIA LIMITED
WEST COAST MINES, T.A.S.

SURVEY BY		SCALE	1 : 500
DRAWN BY		DATE	1973
TRACED BY	P. J. Lowe	REFERENCE	

ROSEBERY MINE
LONGITUDINAL PROJECTION
SPECIFIC STOPES

DRAWING N°:
DEPARTMENT OF MINES

MICROFILMED
PHOTOFILMED

BROUGHT TO DATE 31.12.75
MINE MANAGER *[Signature]*
MINE SURVEYOR *[Signature]*

