


0055_476




FORWARDED

BROUGHT TO DATE : 31.12.75
 MINE MANAGER : *[Signature]*
 MINE SURVEYOR : *[Signature]*

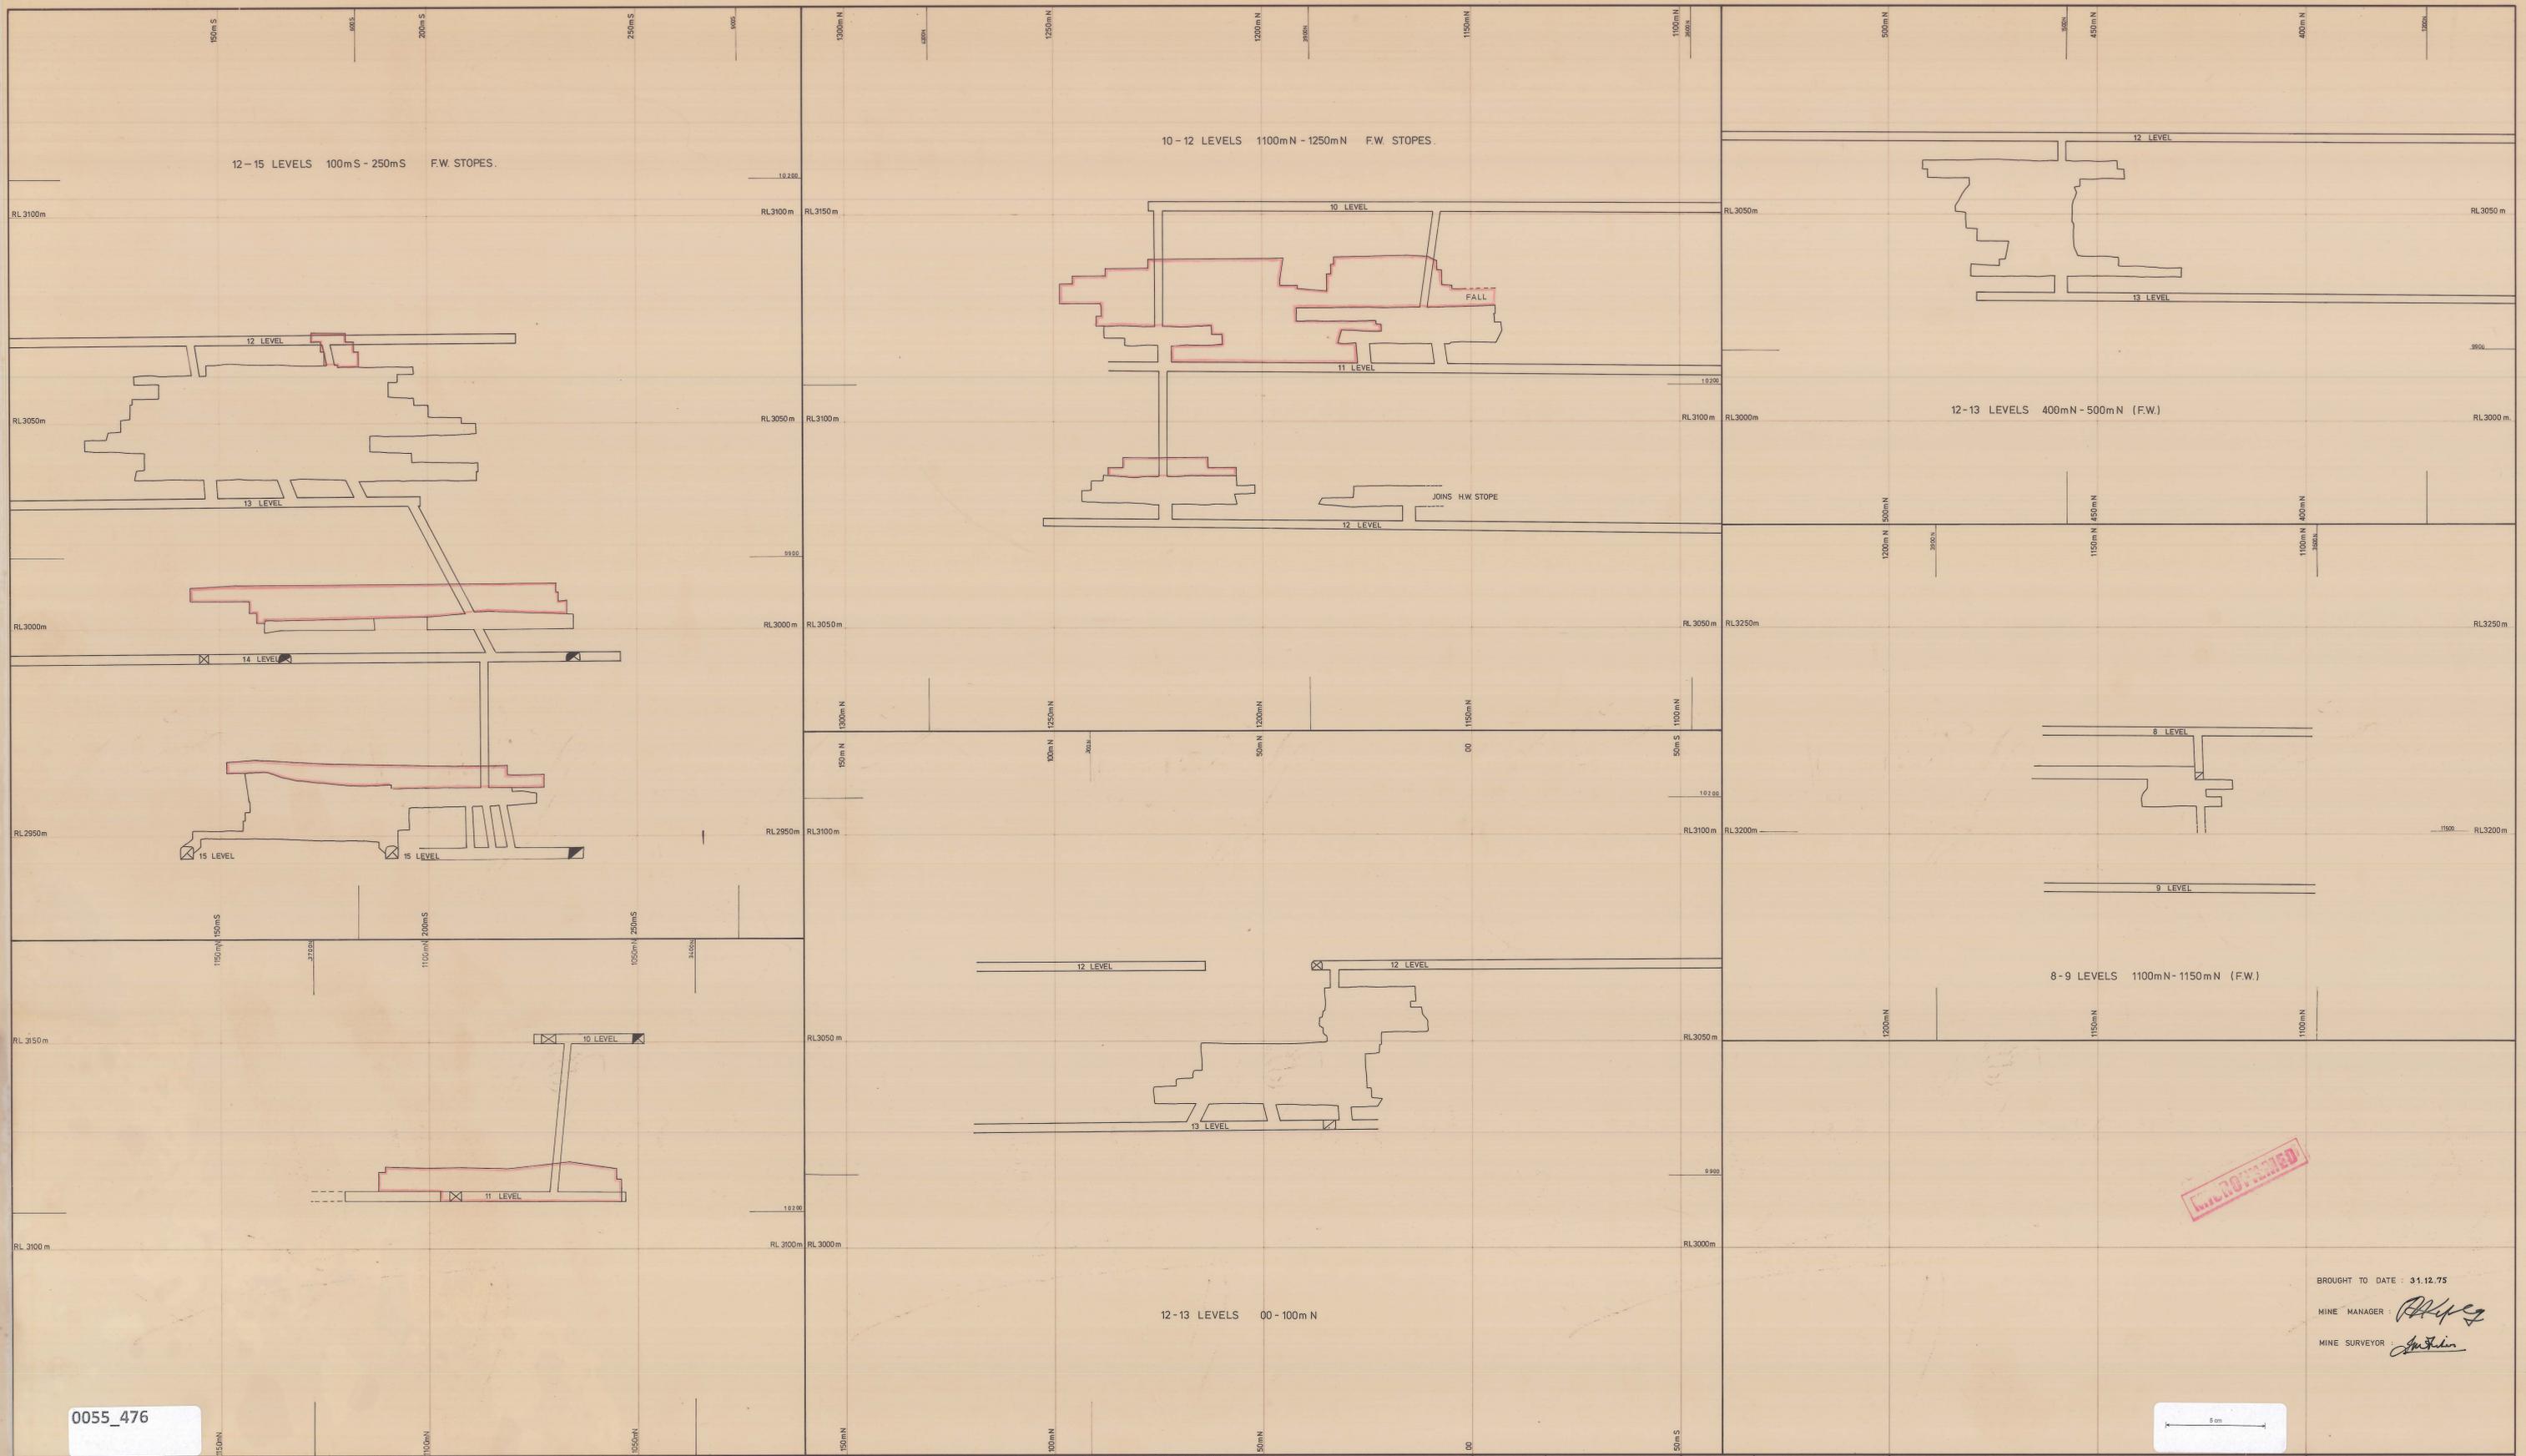

0055_476

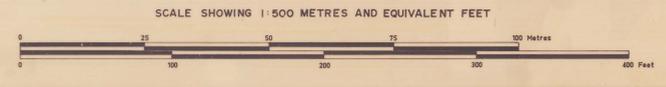

ELECTROLYTIC ZINC COMPANY OF AUSTRALASIA LIMITED
 WEST COAST MINES, T.A.S.

SURVEY BY	SCALE	1 : 500
DRAWN BY	DATE	1973
TRACED BY P. J. Lowe	REFERENCE	

ROSEBERY MINE
 LONGITUDINAL PROJECTION
 SPECIFIC STOPES.

DRAWING NO :
 DEPARTMENT OF MINES
 76080