




0055\_477

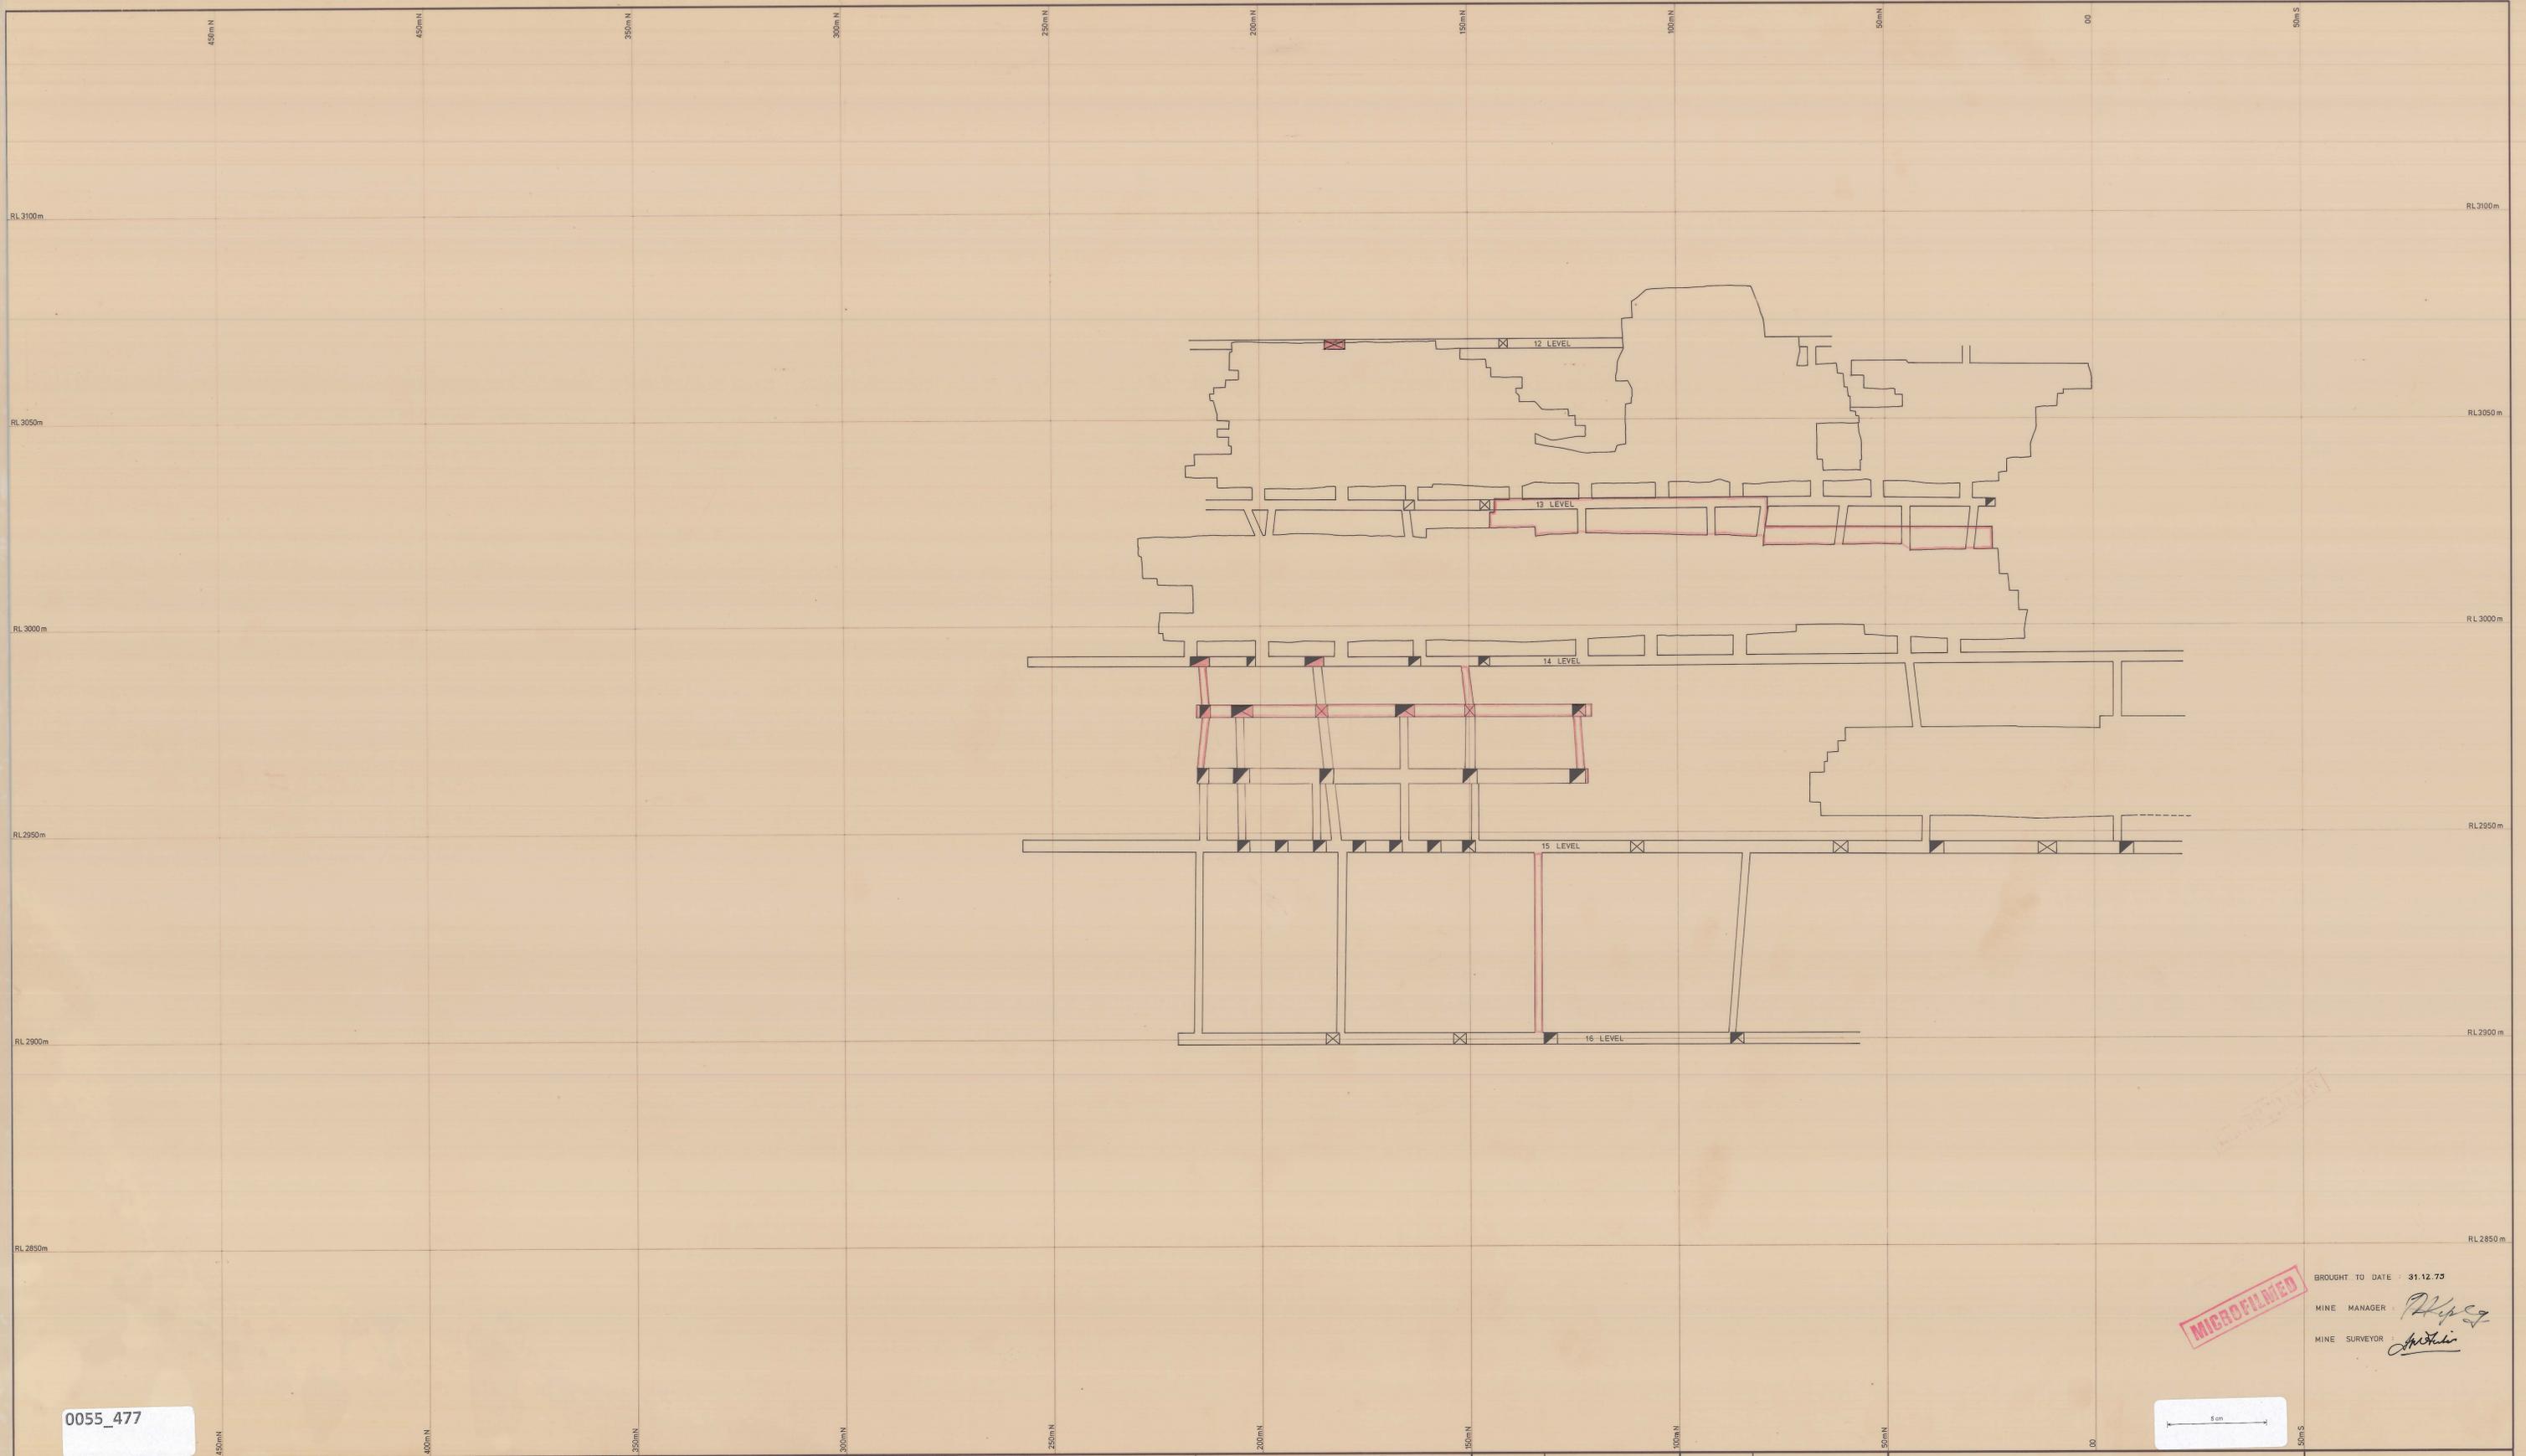

0055\_477

MICROFILMED

BROUGHT TO DATE : 31.12.73  
 MINE MANAGER : *[Signature]*  
 MINE SURVEYOR : *[Signature]*

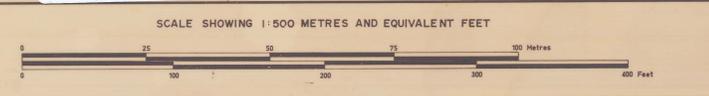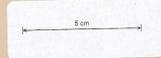

ELECTROLYTIC ZINC COMPANY OF AUSTRALASIA LIMITED  
 WEST COAST MINES, T.A.S.

SURVEY BY		SCALE	1 : 500
DRAWN BY		DATE	1973
TRACED BY	P. J. Lowe	REFERENCE	

ROSEBERY MINE  
 LONGITUDINAL PROJECTION  
 H.W. STOPES.

DRAWING NO :  
 DEPARTMENT OF MINES  
 76071